


15-098-00297-0000

STATE OF KANSAS
STATE CORPORATION COMMISSION
Give All Information Completely
Make Required Affidavit
Mail or Deliver Report to:
Conservation Division
State Corporation Commission
800 Bittling Building
Wichita, Kansas

WELL PLUGGING RECORD

Kingman County. Sec. 1 Twp. 27 Rge. 6 (E) W (W)
Location as "NE/CNW/SW" or footage from lines NE NE NW
Lease Owner Trans Era Petroleum, Inc.
Lease Name Goering Well No. 1
Office Address Russell, Kansas
Character of Well (completed as Oil, Gas or Dry Hole) Dry Hole
Date well completed 9/8/53 19
Application for plugging filed 9/7/53 19
Application for plugging approved 9/7/53 19
Plugging commenced 9/8/53 19
Plugging completed 9/8/53 19
Reason for abandonment of well or producing formation Dry Hole

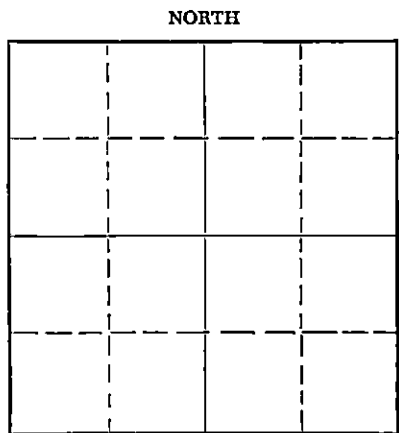

Locate well correctly on above Section Plat

If a producing well is abandoned, date of last production 19
Was permission obtained from the Conservation Division or its agents before plugging was commenced? Yes

Name of Conservation Agent who supervised plugging of this well Rael Durkee
Producing formation _____ Depth to top _____ Bottom _____ Total Depth of Well 4375 Feet
Show depth and thickness of all water, oil and gas formations.

OIL, GAS OR WATER RECORDS

CASING RECORD

FORMATION	CONTENT	FROM	TO	SIZE	PUT IN	PULLED OUT
				8 5/8"	210'	None

Describe in detail the manner in which the well was plugged, indicating where the mud fluid was placed and the method or methods used in introducing it into the hole. If cement or other plugs were used, state the character of same and depth placed, from _____ feet to _____ feet for each plug set.

PLUGGING RECORD

Finished laying down drill pipe, plugged hole with bottom plug set at 210'. Bridge with rock to hold 7 joints of drill pipe, 15 sacks of cement were used. Filled hole with heavy mud to 40', set top plug, 9 sacks of cement were used.

STATE OF KANSAS
SEP 15 1953
CONSERVATION DIVISION

Name of Plugging Contractor _____
Address _____

STATE OF KANSAS, COUNTY OF RUSSELL, ss.
H. R. Michaelis (employee of owner) or (owner or operator) of the above-described well, being first duly sworn on oath, says: That I have knowledge of the facts, statements, and matters herein contained and the log of the above-described well as filed and that the same are true and correct. So help me God.


(Signature) H. R. Michaelis
Russell, Kansas
(Address)

SUBSCRIBED AND SWORN TO before me this 11th day of September, 1953

Margie Cooper
Notary Public.

My commission expires 1-30-57.

24-7388-5 3-53-20M

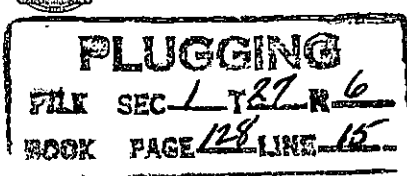

Trans Era Petroleum, Inc.
Goering #1

NE NE NW 1-27-6W
Kingman County, Ks.

Total Depth: 4375'
Comm. 8/13/53
Comp. 9/8/53

Casing

Cement

8 5/8" Set @ 210'

155 sacks Lehig

Formation	Depth
Sand-shale	100
Hard sand	130
Shale-shells-sand	160
Shale-shells	210
Shale	650
Salt-shale	810
Lime-shale	3060
Lime	3466
Lime-shale	3773
Shale-Miss.	3795
Mississippi	4013
Shale-lime	4146
Shale	4166
Shale-Dolo.	4185
Lime-shale	4217
Lime-shale-sand	4237
Shale-sand	4272
Shale	4291
Lime	4321
Arbuckle	4375'

STATE OF KANSAS)
) ss
RUSSELL COUNTY)

I hereby certify that the above information is true and correct to the best of my knowledge.

Caras Baty

Subscribed and sworn to before me this 11th day of September, 1953.

Margie Cooper

Notary Public

9-15-53

My commission expires: 1-30-57.

PLUGGING
RAT SEC 1 T 27 R 6
BOOK PAGE 128 LINE 15

REC
STATE

GOVERNMENT