

STATE OF KANSAS  
STATE CORPORATION COMMISSION  
Give All Information Completely  
Make Required Affidavit  
Mail or Deliver Report to:  
Conservation Division  
State Corporation Commission  
800 Bittling Building  
Wichita, Kansas

### WELL PLUGGING RECORD

Pratt County. Sec. 10 Twp. 26s Rge. (E) 14 (W)

Location as "NE/CNW&SW" or footage from lines. NE $\frac{1}{4}$ -SE $\frac{1}{4}$ -NW $\frac{1}{4}$

Lease Owner Champlin Refining Company

Lease Name Marvin G Moore "B" Well No. 1

Office Address P.O. Drawer #552, Enid, Oklahoma

Character of Well (completed as Oil, Gas or Dry Hole) Dry hole

Date well completed April 5, 19 53

Application for plugging filed April 5, 19 53

Application for plugging approved April 5, (verbal) 19 53


Plugging commenced April 5, 19 53

Plugging completed April 5, 19 53

Reason for abandonment of well or producing formation \_\_\_\_\_

If a producing well is abandoned, date of last production \_\_\_\_\_ 19 \_\_\_\_\_

Was permission obtained from the Conservation Division or its agents before plugging was commenced? Yes

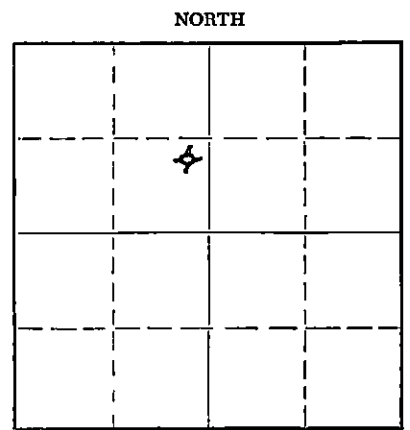

Locate well correctly on above Section Plat

Name of Conservation Agent who supervised plugging of this well M. A. Rives

Producing formation \_\_\_\_\_ Depth to top \_\_\_\_\_ Bottom \_\_\_\_\_ Total Depth of Well 4470 Feet

Show depth and thickness of all water, oil and gas formations.

#### OIL, GAS OR WATER RECORDS

#### CASING RECORD

FORMATION	CONTENT	FROM	TO	SIZE	PUT IN	PULLED OUT
				8 5/8" OD	908'	None

Describe in detail the manner in which the well was plugged, indicating where the mud fluid was placed and the method or methods used in introducing it into the hole. If cement or other plugs were used, state the character of same and depth placed, from \_\_\_\_\_ feet to \_\_\_\_\_ feet for each plug set.

Filled hole with heavy rotary mud from 4470' T.D. to 300' and set wooden plug at 300' and pumped in 40 sacks of cement thru drill pipe on top of plug then filled hole with heavy mud from top of cement to 35' and set wooden plug and pumped in 10 sacks of cement filling hole to bottom of cellar.

4-8-53

RECEIVED  
STATE CORPORATION COMMISSION  
APR 8 - 1953  
CONSERVATION DIVISION  
Wichita, Kansas

(If additional description is necessary, use BACK of this sheet)  
Name of Plugging Contractor Claude Wentworth Drilling Company  
Address Tulsa, Oklahoma

STATE OF Kansas, COUNTY OF Barton, ss.  
S. P. Hall (employee of owner) or owner (operator) of the above-described well, being first duly sworn on oath, says: That I have knowledge of the facts, statements, and matters herein contained and the log of the above-described well as filed and that the same are true and correct. So help me God.

(Signature) S. P. Hall  
P.O. Box 167, Ellinwood, Kansas  
(Address)

SUBSCRIBED AND SWORN TO before me this 7th day of April, 19 53

My commission expires September 10, 1955 N. Kenneth Stevens Notary Public.

**PLUGGING**  
FILE SEC 10 T 26 R 14W  
BOOK PAGE 90 LINE 13

Champlin Refining Company  
 Marvin G. Moore #1  
 Sec. 10 T26s R14w  
 Pratt County, Kansas

0'	-	15'	Surface S & Sand
15'	-	125'	Sand & Shale
125'	-	250'	Sand & Shale
250'	-	585'	Shale & Shells
585'	-	780'	Red Bed
780'	-	866'	Sand "D"
866'	-	885'	Shale & Shells
885'	-	900'	Shale & Shells & Red Bed
900'	-	908'	Anhydrite
880'	-	908'	Cement (Hard) White
908'	-	930'	Anhydrite White
930'	-	1000'	Shale & Shells Grey
1000'	-	1290'	Red Bed & Shale Red
1290'	-	1450'	Salt & Shale
1450'	-	1853'	Shale & Shells
1853'	-	1885'	Lime & Shale
1885'	-	2395'	Lime & Shale
2395'	-	3125'	Shale & Lime
3125'	-	3240'	Lime
3240'	-	3355'	Lime & Shale
3355'	-	3730'	Lime
3730'	-	3800'	Lime & Shale
3800'	-	4075'	Lime
4075'	-	4160'	Lime & Shale
4160'	-	4230'	Lime & Shale & Chert
4230'	-	4293'	Shale & Shells
4293'	-	4421'	Lime
4421'	-	4428'	Shale
4428'	-	4470'	Sand
		4470'	Total Depth.

4-8-53

RECEIVED  
 CORPORATION COMMISSION  
 APR 8 - 1953  
 CONSERVATION DIVISION  
 Topeka, Kansas

**PLUGGING**  
 WELL SEC 10 T 26 R 14 W  
 BOOK PAGE 90 LINE 13