

WELL PLUGGING RECORD

Give All Information Completely  
Make Required Affidavit  
Mail or Deliver Report to:  
Conservation Division  
State Corporation Commission  
211 No. Broadway  
Wichita, Kansas

Pratt County, Sec. 10 Twp. 26S Rge. (X) 14 (W)

Location as "NE/CNW%SW%" or footage from lines NE - SW - SE

Lease Owner Champlin Oil & Refining Co.

Lease Name Henderson "B" Well No. 3

Office Address Box 308, Ellinwood, Kansas

Character of Well (completed as Oil, Gas or Dry Hole) Dry Hole

Date well completed March 10 19 54

Application for plugging filed October 5 19 62

Application for plugging approved October 9 19 62


Plugging commenced October 9 19 62

Plugging completed October 13, 19 62

Reason for abandonment of well or producing formation

If a producing well is abandoned, date of last production 19

Was permission obtained from the Conservation Division or its agents before plugging was commenced? Yes

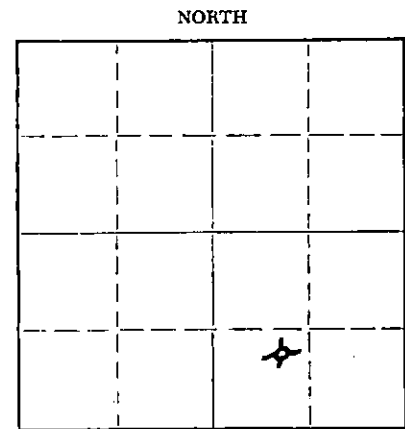

Locate well correctly on above Section Flat

Name of Conservation Agent who supervised plugging of this well Herman Justus

Producing formation Depth to top Bottom Total Depth of Well 4365 Feet

Show depth and thickness of all water, oil and gas formations.

OIL, GAS OR WATER RECORDS

CASING RECORD

FORMATION	CONTENT	FROM	TO	SIZE	PUT IN	PULLED OUT
				8 5/8" OD	904'	None
				5 1/2" OD	4358'	3315'

Describe in detail the manner in which the well was plugged, indicating where the mud fluid was placed and the method or methods used in introducing it into the hole. If cement or other plugs were used, state the character of same and depth placed, from feet to feet for each plug set.

Plugged back with sand from total depth to 4280' and dumped 5 sacks of cement filling hole to 4240' filled hole with mud to 160' set rock bridge to 150' and dumped in 20 sacks of cement to fill hole to 90' then filled hole with mud to 35' set 5' rock bridge then dumped in 10 sacks of cement filling hole from 30' to base of cellar.

RECEIVED  
STATE CORPORATION COMMISSION

OCT 16 1962

CONSERVATION DIVISION  
Wichita, Kansas

10-16-62

(If additional description is necessary, use BACK of this sheet)

Name of Plugging Contractor Ace Pipe Pulling Co. License #2

Address P.O. Box 304, Great Bend, Kansas

STATE OF Kansas, COUNTY OF Barton, ss.

J. W. Meyers (employee of owner) or (operator) of the above-described

well, being first duly sworn on oath, says: That I have knowledge of the facts, statements, and matters herein contained and the log of the above-described well as filed and that the same are true and correct. So help me God.

(Signature) J. W. Meyers

Box 308, Ellinwood, Kansas (Address)

SUBSCRIBED AND SWORN TO before me this 15th day of October 19 62

My commission expires 5-22-66

Notary Public.



CHAMPLIN OIL & REFINING CO.  
 Henderson "B" #3  
 NE $\frac{1}{4}$  SW $\frac{1}{4}$  SE $\frac{1}{4}$   
 Sec. 10 T26S R14W  
 Pratt County, Kansas

0 - 145	Sand and Shale
145 - 250	Sand
250 - 896	Red bed
896 - 904	Anhydrite
904 - 1030	Anhydrite, Shale and Red bed
1030 - 1445	Shale, Shells, Salt
1445 - 1620	Shale
1620 - 1895	Shale & Lime
1895 - 2135	Lime & Shale
2135 - 2340	Shale & Lime
2340 - 2530	Lime & Shale
2530 - 2715	Shale & Lime
2715 - 2955	Lime & Shale
2955 - 3015	Shale & Lime
3015 - 3190	Lime & Shale
3190 - 3385	Shale & Lime
3385 - 3455	Lime & Shale
3455 - 3585	Lime
3585 - 4237	Lime & Shale
4237 - 4259	Lime & Conglomerate
4259 - 4284	Conglomerate & Chert
4284 - 4304	Conglomerate & Sand
4304 - 4325	Sand, Shale & Lime
4325 - 4365	Shale & Lime
4365	Rotary Total Depth
4341	PBTD

RECEIVED  
 STATE CORPORATION COMMISSION  
 OCT 8 1962  
 CONSERVATION DIVISION  
 Wichita, Kansas  
 10-8-62