


STATE OF KANSAS  
STATE CORPORATION COMMISSION

Give All Information Completely  
Make Required Affidavit  
Mail or Deliver Report to:  
Conservation Division  
State Corporation Commission  
800 Bittling Building  
Wichita, Kansas

15-151-00285-00-00  
WELL PLUGGING RECORD

NORTH

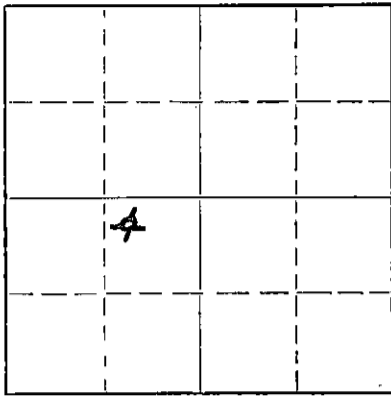

Locate well correctly on above  
Section Plat

Pratt County, Sec. 14 Twp. 26S Rge. (E) 14 (W)  
Location as "NE/CNW&SW" or footage from lines NW $\frac{1}{4}$  NE $\frac{1}{4}$  SW $\frac{1}{4}$   
Lease Owner Champlin Oil & Refining Co.  
Lease Name Mary Moore Well No. 2  
Office Address Box 308, Ellinwood, Kansas  
Character of Well (completed as Oil, Gas or Dry Hole) Oil  
Date well completed February 26, 19 54  
Application for plugging filed July 6, 19 60  
Application for plugging approved July 8, 19 60  
Plugging commenced July 19, 19 60  
Plugging completed July 22, 19 60  
Reason for abandonment of well or producing formation  
Non Commercial Production  
If a producing well is abandoned, date of last production July 7, 19 60  
Was permission obtained from the Conservation Division or its agents before plugging was commenced? Yes

Name of Conservation Agent who supervised plugging of this well Fred Hampel, Pretty Prairie, Kansas  
Producing formation \_\_\_\_\_ Depth to top \_\_\_\_\_ Bottom \_\_\_\_\_ Total Depth of Well 4350 Feet  
Show depth and thickness of all water, oil and gas formations.

OIL, GAS OR WATER RECORDS

CASING RECORD

FORMATION	CONTENT	FROM	TO	SIZE	PUT IN	PULLED OUT
				8 5/8" OD	872'	None
				5 1/2" OD	4349'	3285'

Describe in detail the manner in which the well was plugged, indicating where the mud fluid was placed and the method or methods used in introducing it into the hole. If cement or other plugs were used, state the character of same and depth placed, from \_\_\_\_\_ feet to \_\_\_\_\_ feet for each plug set.

Fill hole with sand from 4320' PBD to 4270' Dumped 4 sacks of cement (mixed) filling hole to 4238'. Then filled hole with mud to 310'. Set rock bridge from 310' to 300' and dumped 20 sacks of cement to fill hole from 300' to 240', then mudded hole to 40' and set rock bridge from 40' to 30' and mixed and dumped 10 sacks of cement filling hole from 30' to bottom of cellar.

7-26-60

RECEIVED  
STATE CORPORATION COMMISSION

JUL 26 1960

CONSERVATION DIVISION  
Wichita, Kansas

(If additional description is necessary, use BACK of this sheet)

Name of Plugging Contractor Ace Pipe Pulling Co. (License #2)  
Address Box 304, Great Bend, Kansas

STATE OF KANSAS, COUNTY OF BARTON, ss.  
J. W. MEYERS

(employee of owner) or (~~owner~~) of the above-described well, being first duly sworn on oath, says: That I have knowledge of the facts, statements, and matters herein contained and the log of the above-described well as filed and that the same are true and correct. So help me, God.

(Signature)

Box 308, Ellinwood, Kansas

(Address)

SUBSCRIBED AND SWORN to before me this 25th day of July 19 60

*[Handwritten Signature]*

Notary Public.

My commission expires 5-22-62



CHAMPLIN OIL & REFINING CO.  
 MARY MOORE #2  
 Located 2310' from South Line  
 & 1700' from West Line of Sec.  
 14-26S-14W, Pratt County, Kansas

FORMATION LOG

<u>FROM</u>	<u>TO</u>	
0'	40'	Surface shale & sand
40'	175'	Sand
175'	600'	Red bed
600'	860'	Red bed and shale
860'	871'	Red bed
871'	900'	Anhydrite
900'	1835'	Shale & Shells
1835'	3990'	Lime & Shale
3990'	4053'	Lime
4053'	4080'	Lime & Shale
4080'	4126'	Lime
4126'	4233'	Lime & Shale
4233'	4296'	Lime & Conglomerate
4296'	4315'	Sand & Shale
4315'	4350'	Shale & Lime
4350'		Total Depth