


STATE OF KANSAS
STATE CORPORATION COMMISSION

WELL PLUGGING RECORD

Give All Information Completely
Make Required Affidavit
Mail or Deliver Report to:
Conservation Division
State Corporation Commission
800 Bittling Building
Wichita, Kansas

Pratt County, Sec. 5 Twp. 26 Rge. 11 (E) W (W)
Location as "NE/CNW/SW" or footage from lines SW SW NW
Lease Owner Helmerich & Payne, Inc.
Lease Name Jorns Well No. 1
Office Address First Nat'l. Building, Tulsa, Oklahoma
Character of Well (completed as Oil, Gas or Dry Hole) Dry Hole
Date well completed June 2 19 53
Application for plugging filed Jne 2 19 53
Application for plugging approved June 2 19 53
Plugging commenced June 2 19 53
Plugging completed June 2 19 53
Reason for abandonment of well or producing formation Dry Hole

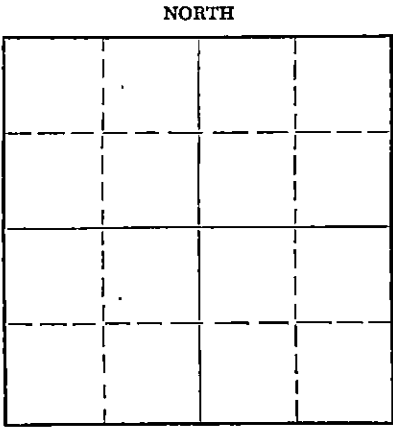

Locate well correctly on above
Section Plot

If a producing well is abandoned, date of last production 19
Was permission obtained from the Conservation Division or its agents before plugging was commenced? Yes

Name of Conservation Agent who supervised plugging of this well M. A. Rieves, Pratt, Kansas
Producing formation _____ Depth to top _____ Bottom _____ Total Depth of Well _____ Feet
Show depth and thickness of all water, oil and gas formations.

OIL, GAS OR WATER RECORDS

CASING RECORD

FORMATION	CONTENT	FROM	TO	SIZE	PUT IN	PULLED OUT
		0	534'	8 5/8"	534'	None

Describe in detail the manner in which the well was plugged, indicating where the mud fluid was placed and the method or methods used in introducing it into the hole. If cement or other plugs were used, state the character of same and depth placed, from _____ feet to _____ feet for each plug set.

4354' - 381 1/2' - Heavy Rotary Mud
381 1/2' - 380' - Wooden Plug
380' - 257' - 40 sacks cement
257' - 41 1/2' - Heavy Rotary Mud
41 1/2' - 40' - Wooden Plug
40' - 6' - 10 sacks cement
6' - Surface - Cellar

(If additional description is necessary, use BACK of this sheet)

Name of Plugging Contractor Peel Brothers, Inc.
Address P. O. Box 88, Hoisington, Kansas


STATE OF Kansas COUNTY OF Barton, ss.
Peel Brothers, Inc. (employee of owner) or (owner or operator) of the above-described well, being first duly sworn on oath, says: That I have knowledge of the facts, statements, and matters herein contained and the log of the above-described well as filed and that the same are true and correct. So help me God. PEEL BROTHERS, INC.

(Signature) BY: *R. B. Juter*
P. O. Box 88, Hoisington, Kansas

SUBSCRIBED AND SWORN TO before me this 9th day of June, 19 53

Meris B. Welch
Notary Public.

My commission expires January 9, 1957

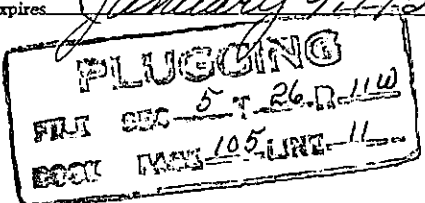

24-7366-S 3-53-20M

JED 6-13-53
COMMISSIONER
13 1953
CONSERVATION DIVISION
Wichita, Kansas

DRILLER'S LOG

Company: Helmerich & Payne, Inc.

SW SW NW
Sec. 5, Twp. 26, Rge. 11W

Farm: Jorns Well No. 1

Total Depth: 4354

County: Pratt,
Kansas

Comm: 4-30-53 Comp.: 6-2-53
Contractor: Peel Brothers, Inc.

Elevation:

Casing: 8 5/8" 534' cem.

Production: Dry

Figures below indicate bottom of formations

Surface Clay	0 -	130
Shale		195
Shale & Red Bed		480
Sand		505
Sand & Red Bed		730
Sand		740
Red Bed & Shells		850
Blue Shale & Shells		1065
Shells & Anhydrite streaks		1120
Shale		1570
Salt & Shells		1620
Shale		1640
Shale & Shells		1690
Lime & Shale		3355
Lime		4038
Conglomerate		4125
Lime & Chert		4225
Lime & Sandy Shale		4250
Shale, Sand, & Lime		4300
Arbuckle		4354
Total Depth		4354

This is to certify that the above information is to the best of my knowledge true and correct.

PEEL BROTHERS, INC.

BY: *H. P. Suter*

SUBSCRIBED AND SWORN to before me this 9th day of June, 1953.

My commission expires January 9, 1957

Marie S. Welch
Notary Public

