

CARD MUST BE TYPED

State of Kansas  
**NOTICE OF INTENTION TO DRILL**  
(see rules on reverse side)

CARD MUST BE SIGNED

Starting Date: ..... 7 ..... 26 ..... 85 .....  
month day year

API Number 15- 151-21,657-00-00

**OPERATOR:** License # 9232  
Name Timberline Oil & Gas Corporation  
Address 105 E. 8th Street  
City/State/Zip Pratt, KS 67124  
Contact Person Brant C. Grote or Roy Knappe, Jr.  
Phone (316) 672-9476

SE NW NE ..... Sec 33 Twp 26 S, Rge 13 .....  
(location)  East  West

4290 ..... Ft North from Southeast Corner of Section  
1650 ..... Ft West from Southeast Corner of Section  
(Note: Locate well on Section Plat on reverse side)

**CONTRACTOR:** License # 5138  
Name Cougar Drilling Co., Inc.  
City/State Wichita, Kansas

Nearest lease or unit boundary line ..... 330 ..... feet.  
County Pratt  
Lease Name Becker Well# 4

**Well Drilled For:** **Well Class:** **Type Equipment:**  
 Oil  Swd  Infield  Mud Rotary  
 Gas  Inj  Pool Ext.  Air Rotary  
 OWWO  Expl  Wildcat  Cable

Domestic well within 330 feet :  yes  no  
Municipal well within one mile :  yes  no

If OWWO: old well info as follows:

Operator .....  
Well Name .....  
Comp Date ..... Old Total Depth .....  
Projected Total Depth 4500 ..... feet  
Projected Formation at TD Arbuckle .....  
Expected Producing Formations Arbuckle .....

Depth to Bottom of fresh water ..... 200 ..... feet  
Lowest usable water formation Nippewalla Group-L. Permian  
Depth to Bottom of usable water ..... 250 ..... feet  
Surface pipe by Alternate : 1  2   
Surface pipe to be set ..... 300 ..... feet  
Conductor pipe if any required ..... NA ..... feet  
Ground surface elevation ..... 1947 ..... feet MSL  
This Authorization Expires ..... 1-17-86 .....  
Approved By ..... 7-17-85 .....  
RCH for KDHE

I certify that we will comply with K.S.A. 55-101, et seq., plus eventually plugging hole to K.C.C. specifications.

Date 7/16/85 ..... Signature of Operator or Agent

Roy Knappe Jr

Title Vice President

Must be filed with the K.C.C. five (5) days prior to commencing well  
This card void if drilling not started within six (6) months of date received by K.C.C.

CONSERVATION DIVISION  
Wichita, Kansas


7-17-85

Important procedures to follow:

A Regular Section of Land

1 Mile = 5,280 Ft.

RECEIVED  
STATE CORPORATION COMMISSION

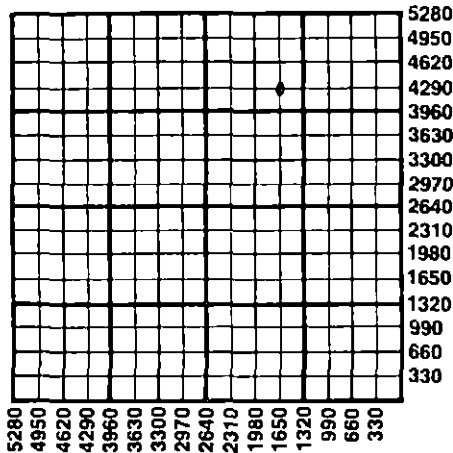

1. Notify District office before setting surface casing.
2. Set surface casing by circulating cement to the top.
3. File completion forms ACO-1 with K.C.C. within 90 days of well completion, following instructions on ACO-1, side 1, and including copies of wireline logs.
4. Notify District office 48 hours prior to old well workover or re-entry.
5. Prior to plugging, prepare a plugging plan, then obtain agreement from the appropriate district office for an approved plugging plan.
6. Submit plugging report (CP-4) to K.C.C. after plugging is completed.
7. Obtain an approved injection docket number before disposing of salt water.
8. Notify K.C.C. within 10 days when injection commences or terminates.
9. If an alternate 2 completion, cement in the production pipe from below any usable water to surface within 120 days of spud date.

State Corporation Commission of Kansas  
Conservation Division  
200 Colorado Derby Building  
Wichita, Kansas 67202  
(316) 263-3238