

CARD MUST BE TYPED

State of Kansas

CARD MUST BE SIGNED

NOTICE OF INTENTION TO DRILL

(see rules on reverse side)

Starting Date 12/10/1986 month day year

API Number 15-095-21,563-0000

OPERATOR: License # 5039 Name Attica Gas Venture Address 123 North Main City/State/Zip Attica, KS 67009 Contact Person Carl Durr Phone 316-254-7222

SW NW Sec. 19 Twp. 27 S, Rg. 6 West 3300 Ft. from South Line of Section 4620 Ft. from East Line of Section

(Note: Locate well on Section Plat on reverse side)

CONTRACTOR: License # Unknown 5929 Name Duke Drilling Co, Inc City/State

Nearest lease or unit boundary line 660 feet County Kingman Lease Name Hoover Well # 1-86 Ground surface elevation N/A feet MSL Domestic well within 330 feet: yes no Municipal well within one mile: yes no Depth to bottom of fresh water 40 Depth to bottom of usable water 200 Surface pipe by Alternate: 1 x 2 Surface pipe planned to be set 275 Conductor pipe required None Projected Total Depth 4400 feet Formation Viola

Well Drilled For: Oil SWD Infield Mud Rotary Gas Inj Pool Ext Air Rotary OWWO Expl Wildcat Cable

If OWWO: old well info as follows:

Operator Well Name Comp Date Old Total Depth

I certify that well will comply with K.S.A. 55-101, et seq., plus eventually plugging hole to KCC specifications.

Date 12-1-86 Signature of Operator or Agent Carl Durr Title Drlg/Prod/Engineer

For KCC Use:

Conductor Pipe Required feet; Minimum Surface Pipe Required 200 feet per Alt.

This Authorization Expires 6-4-87 Approved By 12-4-86


Handwritten signatures and initials at the bottom right of the form.

Must be filed with the K.C.C. five (5) days prior to commencing well
This card void if drilling not started within six (6) months of date received by K.C.C.

Important procedures to follow:

1. Notify District office before setting surface casing.
2. Set surface casing by circulating cement to the top.
3. File completion forms ACO-1 with K.C.C. within 90 days of well completion, following instructions on ACO-1, side 1, and including copies of wireline logs.
4. Notify District office 48 hours prior to old well workover or re-entry.
5. Prior to filing Intent, prepare a proposed plugging plan in case well is D & A, then obtain approval of plan when calling district office prior to setting surface pipe.
6. Submit plugging report (CP-4) to K.C.C. after plugging is completed.
7. Obtain an approved injection docket number before disposing of salt water.
8. Notify K.C.C. within 10 days when injection commences or terminates.

A Regular Section of Land 1 Mile = 5,280 Ft.

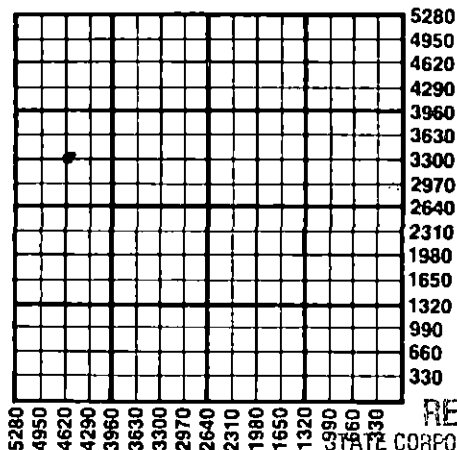

RECEIVED

STATE CORPORATION COMMISSION

12-4-86

DEC - 4 1986

CONSERVATION DIVISION
Wichita, Kansas

9. If an alternate 2 completion, cement in the production pipe from below any usable water to surface within 120 days of spud date.

State Corporation Commission of Kansas
Conservation Division
200 Colorado Derby Building
Wichita, Kansas 67202
(316) 263-3238