

CARD MUST BE TYPED

CORRECTED CARD

NOTICE OF INTENTION TO DRILL

State of Kansas
(see rules on reverse side)

CARD MUST BE SIGNED

CORRECTION

62085

Starting Date: July 15, 1985
month day year

API Number 15- 095-21, 529-0000

OPERATOR: License # 5898

Name Voth Oil Co., Inc.
Address 902 N. West Street
City/State/Zip Wichita, Kansas 67203
Contact Person Randall J. Voth
Phone 945-9688

CONTRACTOR: License # 5418

Name Allen Drilling Co.
City/State Great Bend, Kansas

* 1/2 N/2 NW NE Sec 13 Twp 27 S, Rge 6
(location)

4950 Ft North from Southeast Corner of Section
* 1980 Ft West from Southeast Corner of Section
(Note: Locate well on Section Plat on reverse side)

Nearest lease or unit boundary line 330 feet.
County Kingman
Lease Name Hageman Well# 1
Domestic well within 330 feet: ☐ yes ☒ no
Municipal well within one mile: ☐ yes ☒ no

Well Drilled For: Well Class: Type Equipment:
☐ Oil ☐ Swd ☐ Infield ☒ Mud Rotary
☒ Gas ☐ Inj ☐ Pool Ext. ☐ Air Rotary
☐ OWWO ☐ Expl ☒ Wildcat ☐ Cable

If OWWO: old well info as follows:

Operator
Well Name
Comp Date Old Total Depth
Projected Total Depth 2900 feet
Projected Formation at TD Douglas
Expected Producing Formations Douglas

Depth to Bottom of fresh water 200 feet
Lowest usable water formation Consolidated
Depth to Bottom of usable water 200 feet
Surface pipe by Alternate: 1 ☒ 2 ☐
Surface pipe to be set 250 feet
Conductor pipe if any required
Ground surface elevation 1500 feet MSL
This Authorization Expires 12-14-85
Approved By 6-14-85

I certify that we will comply with K.S.A. 55-101, et seq., plus eventually plugging hole to K.C.C. specifications.


Date 6-17-85 Signature of Operator or Agent

[Signature]
Title President

Must be filed with the K.C.C. five (5) days prior to commencing well
This card void if drilling not started within six (6) months of date received by K.C.C.

Important procedures to follow :

**A Regular Section of Land
1 Mile = 5,280 Ft.**

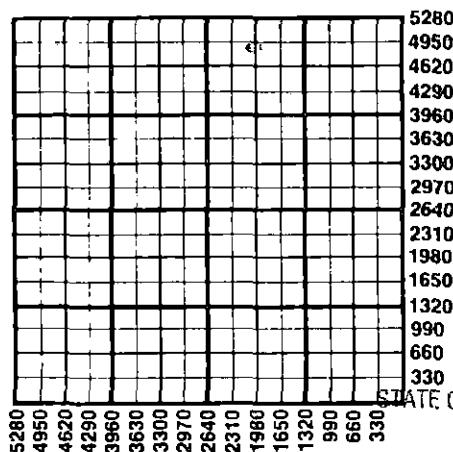

1. Notify District office before setting surface casing.
 2. Set surface casing by circulating cement to the top.
 3. File completion forms ACO-1 with K.C.C. within 90 days of well completion, following instructions on ACO-1, side 1, and including copies of wireline logs.
 4. Notify District office 48 hours prior to old well workover or re-entry.
 5. Prior to plugging, prepare a plugging plan, then obtain agreement from the appropriate district office for an approved plugging plan.
 6. Submit plugging report (CP-4) to K.C.C. after plugging is completed.
 7. Obtain an approved injection docket number before disposing of salt water.
 8. Notify K.C.C. within 10 days when injection commences or terminates.
9. If an alternate 2 completion, cement in the production pipe from below any usable water to surface within 120 days of spud date.

RECEIVED
STATE CORPORATION COMMISSION
6-20-85
JUN 20 1985

CONSERVATION DIVISION
Wichita, Kansas

State Corporation Commission of Kansas
Conservation Division
200 Colorado Derby Building
Wichita, Kansas 67202
(316) 263-3238