

CARD MUST BE TYPED

State of Kansas
NOTICE OF INTENTION TO DRILL
(see rules on reverse side)

CARD MUST BE SIGNED

Starting Date: 07 10 84
month day year

API Number 15- 095-21,468-0000

OPERATOR: License # 8411
Name Gruy Management Service Co.
Address 150 W. John W. Carpenter Frwy.
City/State/Zip Irving, Texas 75062
Contact Person Tom Ballew
Phone

..... CN $\frac{1}{2}$ SE 4 Sec 12 Twp 27 S, Rge 6
(location) East West

..... 1980 Ft North from Southeast Corner of Section
..... 1320 Ft West from Southeast Corner of Section
(Note: Locate well on Section Plat on reverse side)

CONTRACTOR: License #
Name
City/State

Nearest lease or unit boundary line 1320 feet.
County Kingman
Lease Name Goering Well# 1

Well Drilled For: Well Class: Type Equipment:

- Oil Swd Infield Mud Rotary
- Gas Inj Pool Ext. Air Rotary
- OWWO Expl Wildcat Cable

Domestic well within 330 feet: yes no
Municipal well within one mile: yes no

If OWWO: old well info as follows:

Operator
Well Name
Comp Date Old Total Depth
Projected Total Depth 3000 feet
Projected Formation at TD Douglas "A"
Expected Producing Formations Douglas "A"

Depth to Bottom of fresh water 200 feet
Lowest usable water formation N. W. 1/4 Sec 4
Depth to Bottom of usable water 200 feet
Surface pipe by Alternate: 1 2
Surface pipe to be set 250 feet
Conductor pipe if any required None feet
Ground surface elevation 1500 Appx. feet MSL
This Authorization Expires 11/9/85
Approved By 7/9/84 [Signature]

I certify that we will comply with K.S.A. 55-101, et seq., plus eventually plugging hole to K.C.C. specifications.

Date 7/15/84 ... Signature of Operator or Agent Tom E. Ballew Title Administrative Assistant
Tom E. Ballew
MHC/KDHE 7-9-84
Form C-1 4/84

Must be filed with the K.C.C. five (5) days prior to commencing well
This card void if drilling not started within six (6) months of date received by K.C.C.


RECEIVED 7-9-84
STATE CORPORATION COMMISSION

Important procedures to follow:

A Regular Section of Land
1 Mile = 5,280 Ft.

JUL 09 1984

CONSERVATION DIVISION
Wichita, Kansas

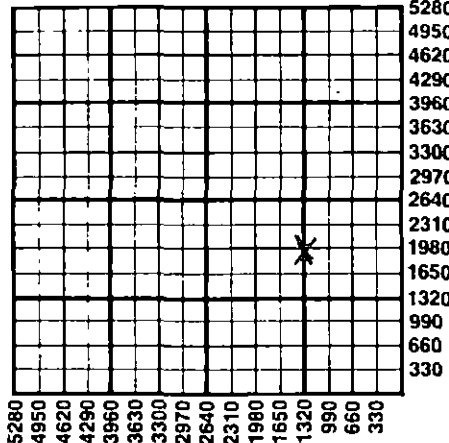

1. Notify District office before setting surface casing.
2. Set surface casing by circulating cement to the top.
3. File completion forms ACO-1 with K.C.C. within 90 days of well completion, following instructions on ACO-1, side 1, and including copies of wireline logs.
4. Notify District office 48 hours prior to old well workover or re-entry.
5. Prior to plugging, prepare a plugging plan, then obtain agreement from the appropriate district office for an approved plugging plan.
6. Submit plugging report (CP-4) to K.C.C. after plugging is completed.
7. Obtain an approved injection docket number before disposing of salt water.
8. Notify K.C.C. within 10 days when injection commences or terminates.
9. If an alternate 2 completion, cement in the production pipe from below any usable water to surface within 120 days of spud date.

State Corporation Commission of Kansas
Conservation Division
200 Colorado Derby Building
Wichita, Kansas 67202
(316) 263-3238