

CARD MUST BE TYPED

State of Kansas
NOTICE OF INTENTION TO DRILL
(see rules on reverse side)

COLLECTED
CARD MUST BE SIGNED
10-8-84

Starting Date: 10 6 84
month day year

API Number 15- 151-21,478 - 00-00

OPERATOR: License # 5087
Name Texas Energies, Inc.,
Address P.O. Box 947
City/State/Zip Pratt, KS 67124
Contact Person Scott Alberg
Phone 316-672-7581

* SW .. NW .. SW Sec 5 .. Twp 26 .. S, Rge 11. East
(location) West

* 1650 Ft North from Southeast Corner of Section
..... 4950 Ft West from Southeast Corner of Section
(Note: Locate well on Section Plat on reverse side)

CONTRACTOR: License # 5149
Name Wheatstate Oilfield Services
City/State Pratt, KS 67124

Nearest lease or unit boundary line 330 feet.
County Pratt
Lease Name Long Well# 3-5

Domestic well within 330 feet: yes no
Municipal well within one mile: yes no

Well Drilled For: Well Class: Type Equipment:
 Oil Swd Infield Mud Rotary
 Gas Inj Pool Ext. Air Rotary
 OWWO Expl Wildcat Cable

Depth to Bottom of fresh water 150 feet
Lowest usable water formation Nippewalla
Depth to Bottom of usable water 250 feet
Surface pipe by Alternate: 1 2
Surface pipe to be set 300 feet
Conductor pipe if any required none feet
Ground surface elevation feet MSL
This Authorization Expires 5-5-85
Approved By *9-524*

If OWWO: old well info as follows:
Operator
Well Name
Comp Date Old Total Depth
Projected Total Depth 4300 feet
Projected Formation at TD Mississippian
Expected Producing Formations Mississippian

I certify that we will comply with K.S.A. 55-101, et seq., plus eventually plugging hole to K.C.C. specifications. *W23 SE N13W 4270 FEL
Date .. 10-4-84 Signature of Operator or Agent *Scott Alberg* Title Operations Geologist


Must be filed with the K.C.C. five (5) days prior to commencing well
This card void if drilling not started within six (6) months of date received by K.C.C.

10-5-84

RECEIVED
STATE CORPORATION COMMISSION

Important procedures to follow: OCT 05 1984

A Regular Section of Land
1 Mile = 5,280 Ft.

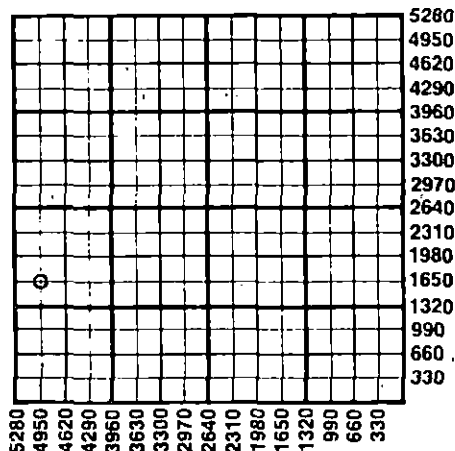

1. Notify District office before setting surface casing. CONSERVATION DIVISION, Wichita, Kansas
2. Set surface casing by circulating cement to the top. CONSERVATION DIVISION, Wichita, Kansas
3. File completion forms ACO-1 with K.C.C. within 90 days of well completion, following instructions on ACO-1, side 1, and including copies of wireline logs.
4. Notify District office 48 hours prior to old well workover or re-entry.
5. Prior to plugging, prepare a plugging plan, then obtain agreement from the appropriate district office for an approved plugging plan.
6. Submit plugging report (CP-4) to K.C.C. after plugging is completed.
7. Obtain an approved injection docket number before disposing of salt water.
8. Notify K.C.C. within 10 days when injection commences or terminates.
9. If an alternate 2 completion, cement in the production pipe from below any usable water to surface within 120 days of spud date.

State Corporation Commission of Kansas
Conservation Division
200 Colorado Derby Building
Wichita, Kansas 67202
(316) 263-3238