

EFFECTIVE DATE: 3-23-91

FORM MUST BE TYPED
FORM C-1 4/90

State of Kansas

NOTICE OF INTENTION TO DRILL

FORM MUST BE SIGNED
ALL BLANKS MUST BE FILLED

Must be approved by the K.C.C. five (5) days prior to commencing well

Expected Spud Date March 18 1991 NW SE NE Sec 5 Twp 26 S, Rg 11 X East West

..... 3630 feet from South line of Section
..... 990 feet from East line of Section

OPERATOR: License # 30349
Name: Vess - TRANS PACIFIC OPERATING CO. (Note: Locate well on Section Plat on Reverse Side)
Address: 8100 E. 22nd St. North
City/State/Zip: Wichita, KS 67226
Contact Person: Bill Horigan
Phone: 316-682-1537

County: Pratt
Lease Name: Rundell Well #: 2
Field Name: Bauman

CONTRACTOR: License #: 5929
Name: Duke Drilling Co., Inc.

Is this a Prorated Field? ... yes X no
Target Formation(s): Miss.
Nearest lease or unit boundary: 330'

Well Drilled For: Well Class: Type Equipment:
X Oil ... Inj X Infield X Mud Rotary
... Gas ... Storage ... Pool Ext. ... Air Rotary
... OWWO ... Disposal ... Wildcat ... Cable
... Seismic; ... # of Holes

Ground Surface Elevation: 1844 feet MSL
Domestic well within 330 feet: ... yes X no
Municipal well within one mile: ... yes X no
Depth to bottom of fresh water: 180
Depth to bottom of usable water: 200
Surface Pipe by Alternate: X 1 ... 2

If OWO: old well information as follows:
Operator:
Well Name:
Comp. Date: Old Total Depth

Length of Surface Pipe Planned to be set: 250'
Length of Conductor pipe required:
Projected Total Depth: 4250'
Formation at Total Depth: Mississippi
Water Source for Drilling Operations:
X well ... farm pond ... other

Directional, Deviated or Horizontal wellbore? ... yes X no
If yes, total depth location:

DWR Permit #: Not available yet
Will Cores Be Taken?: ... yes X no
If yes, proposed zone:

AFFIDAVIT

The undersigned hereby affirms that the drilling, completion and eventual plugging of this well will comply with K.S.A. 55-101, et. seq.

It is agreed that the following minimum requirements will be met:

1. The appropriate district office shall be notified before setting surface pipe;
2. The minimum amount of surface pipe as specified above shall be set by circulating cement to the top; in all cases surface pipe shall be set through all unconsolidated materials plus a minimum of 20 feet into the underlying formation;
3. If the well is dry, a plugging proposal shall be submitted to the district office. An agreement between the operator and the district office on plug length and placement is necessary prior to plugging;
4. The appropriate district office will be notified before well is either plugged or production casing is cemented in;
5. If an Alternate II completion, production pipe shall be cemented from below any usable water to surface within 120 days of spud date. In all cases, notify district office prior to any cementing.

I hereby certify that the statements made herein are true and to the best of my knowledge and belief.

Date: 3/12/91 Signature of Operator or Agent: WR Horigan Title: Operations Manager

RECEIVED
STATE CORPORATION COMMISSION
3-14-91
MAR 14 1991
CONSERVATION DIVISION
Wichita, Kansas

FOR KCC USE:	
API # 15-	<u>151-22,044-00-00</u>
Conductor pipe required	<u>None</u> feet
Minimum surface pipe required	<u>350</u> feet per Alt <u>1</u>
Approved by:	<u>man 3-18-91</u>
EFFECTIVE DATE:	<u>3-23-91</u>
This authorization expires:	<u>9-18-91</u>
(This authorization void if drilling not started within 6 months of effective date.)	
Spud date:	Agent:

5
26
114

REMEMBER TO:

- File Drill Pit Application (form CDP-1) with Intent to Drill;
- File Completion Form ACO-1 within 120 days of spud date;
- File acreage attribution plat according to field proration orders;
- Notify appropriate district office 48 hours prior to workover or re-entry;
- Submit plugging report (CP-4) after plugging is completed;
- Obtain written approval before disposing or injecting salt water.


PLAT OF ACREAGE ATTRIBUTABLE TO A WELL

State Corporation Commission, Conservation Division
200 Colorado Derby Bldg. Wichita, Kansas 67202

OPERATOR Vess Oil Corporation LOCATION OF WELL:
 LEASE Rundell 3630 feet north of SE corner
 WELL NUMBER 1-5 990 feet west of SE corner
 FIELD Bauman NE/4 Sec. 5 T 26 R 11 ~~NE~~W
 COUNTY Pratt
 NO. OF ACRES ATTRIBUTABLE TO WELL 10 IS SECTION REGULAR IRREGULAR?
 IF IRREGULAR, LOCATE WELL FROM NEAREST
 DESCRIPTION OF ACREAGE NW SE NE CORNER BOUNDARY.

NOTE: If plat depicted is insufficient for your circumstances, you may attach your own scaled or surveyed plat.

PLAT

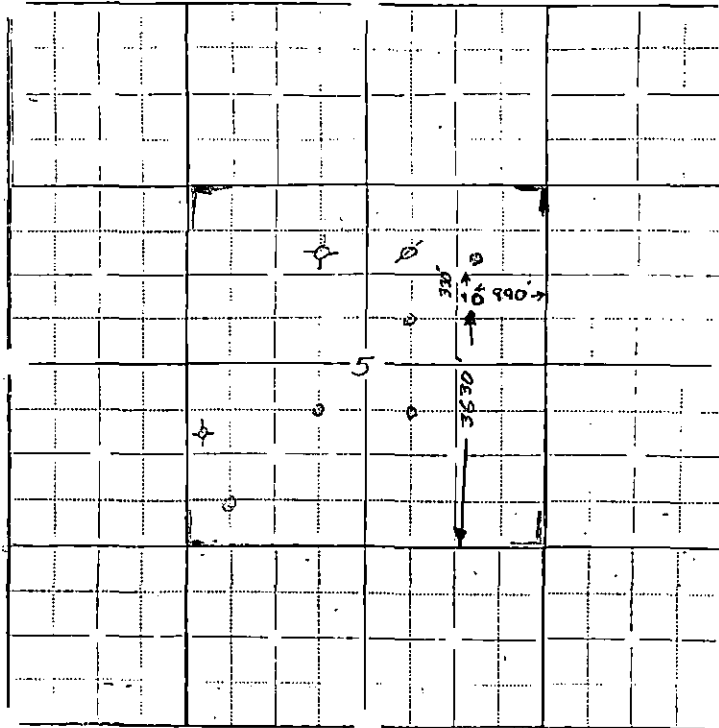

In plotting the proposed location of the well, you must show:

- 1) The manner in which you are using the depicted plat by identifying section lines, i.e. 1 section, 1 section with 8 surrounding partial sections, 4 sections, 16 sections, etc.;
- 2) the well's location relative to the location of other wells producing from the same common source of supply in adjoining drilling units, pursuant to K.A.R. 82-3-108, 82-3-207, 82-3-312, or special orders of the Commission;
- 3) the distance of the proposed drilling location from the section's east and south lines; and
- 4) the distance to the nearest lease or unit boundary line.

I hereby certify that the statements made herein are true and to the best of my knowledge and belief.

Signature of Operator or Agent WR Hanna
 Date 3/12/91 Title Operations Manager