

15-151-10769-00-00

STATE OF KANSAS
STATE CORPORATION COMMISSION


Give All Information Completely
Make Required Affidavit

Mail or Deliver Report to:
Conservation Division
State Corporation Commission
800 Bittling Building
Wichita, Kansas

WELL PLUGGING RECORD

Pratt County, Sec. 26 Twp. 26S Rge. 13 (E) (W)

Location as "NE/CNW/SW" or footage from lines C SW SW SE
Lease Owner San Diego Corporation
Lease Name Gobin Well No. 3
Office Address 1720 1st National Bldg., Tulsa, Oklahoma
Character of Well (completed as Oil, Gas or Dry Hole) Dry Hole
Date well completed May 21, 1955
Application for plugging filed Verbal application to M.A.Rives 5/21/55
Application for plugging approved May 23, 1955
Plugging commenced May 21, 1955
Plugging completed May 21, 1955
Reason for abandonment of well or producing formation Dry

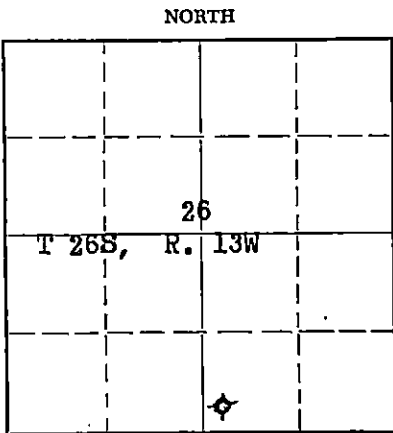

Locate well correctly on above Section Plat

If a producing well is abandoned, date of last production 19
Was permission obtained from the Conservation Division or its agents before plugging was commenced? Yes

Name of Conservation Agent who supervised plugging of this well M. A. Rives
Producing formation Dry Depth to top Bottom Total Depth of Well 4405 Feet
Show depth and thickness of all water, oil and gas formations.

OIL, GAS OR WATER RECORDS

CASING RECORD

FORMATION	CONTENT	FROM	TO	SIZE	PUT IN	PULLED OUT
Heebner	(Shale)	3568		10-3/4"	453	None
Brown Lime	(Dense)	3736	3746			
Lansing-Kansas City	S.W.	3764	4086			
Marmaton	S.W.	4086	4182			
Mississippi Ln.	(Dense) SW	4182	4200			
Viola	SW	4251	4289			
Simpson	SW	4289	4392			
Arbuckle	SW	4392	4405(TD)			

Describe in detail the manner in which the well was plugged, indicating where the mud fluid was placed and the method or methods used in introducing it into the hole. If cement or other plugs were used, state the character of same and depth placed, from feet to feet for each plug set.

- (1) Hole filled with mud
- (2) Set Halliburton plug in surface pipe @ 300'
- (3) Placed 1/2 sack cotton seed hulls on plug
- (4) Pumped 25 sacks of cement on top of hulls
- (5) Set top Halliburton plug in surface pipe @ 30'
- (6) Placed 1/2 sack cotton seed hulls on top of top plug
- (7) Pumped 13 sacks of cement on top of hulls-filled up to within 5' of surface

All of above plugging work done with rotary drilling tools-Rotary Contractor:
Iron Drilling Company.

(If additional description is necessary, use BACK of this sheet)
Name of Plugging Contractor (Iron Drilling Co.-Rotary drilling tools contractor)
Address Philhower Building, Tulsa, Oklahoma

STATE OF OKLAHOMA, COUNTY OF TULSA, ss.
Robert B. Wilkins (employee of owner) or (owner or operator) of the above-described well, being first duly sworn on oath, says: That I have knowledge of the facts, statements, and matters herein contained and the log of the above-described well as filed and that the same are true and correct. So help me God.

(Signature) Robert B. Wilkins
1720 First Natl Bldg, Tulsa, Okla
(Address)

SUBSCRIBED AND SWORN TO before me this 25 day of May, 19 55

My commission expires My Commission Expires 6-9-1958

Hannette Hayden Notary Public.

PLUGGING
SEC 26 T 26S R 13W
PAGE 20 LINE 39

RECEIVED
STATE CORPORATION COMMISSION
MAY 27 1955
CONSERVATION DIVISION
Wichita, Kansas

SAN DIEGO CORPORATION- GOBIN WELL NO. 3

C SW SW SE Sec. 26, T26S, R 13 W, Pratt County, Kansas

W E L L L O G

Well spudded @ 6:30 P.M. 5/4/55

Set 10-3/4 surface pipe @ 453 ft. cement circulated to surface

Top Heebner Sh. @ 3568'

Top Brown Lime @ 3736' (dense)

Top Lansing-Kansas City @ 3764' (all zones salt water bearing)

Top Marmaton @ 4086' (Salt water)

Top Mississippi Lime @ 4182' (Dense-Salt water bearing)

Viola @ 4251' (Dense-Salt water bearing)

Simpson @ 4289' (Salt water)

Arbuckle @ 4392' (Salt water)

Well P & A 5/21/55

5-27-55

RECEIVED
STATE CORPORATION
MAY 27 1955
CONSERVATION DIVISION
Wichita, Kansas

PLUGGING			
FILE	SEC 26	T 26	R 13W
BOOK	PAGE 120	LINE	39