

STATE OF KANSAS  
STATE CORPORATION COMMISSION


Form CP-4

Give All Information Completely  
State Required Address  
Mail or Deliver Report to  
Conservation Division  
State Corporation Commission

WELL PLUGGING RECORD

P. O. Box 17027  
Wichita, Kansas 67217

Pratt County, Sec. 27 Twp. 26 Rge. 13 (E) W (W)  
Location as "NE/CNW/SE" or footage from lines SE SW SE  
Lease Owner Dunne - Gardner Petroleum Inc.  
Lease Name Soeken Well No #1  
Office Address 200 W Douglas, Suite 250 ; Wichita, Kans.  
Character of Well (completed as Oil, Gas or Dry Hole) Oil well  
Date well completed July 12 19 67  
Application for plugging filed March 1974  
Application for plugging approved March 1974  
Plugging commenced March 18 1974  
Plugging completed April 3 1974  
Reason for abandonment of well or producing formation Depleted

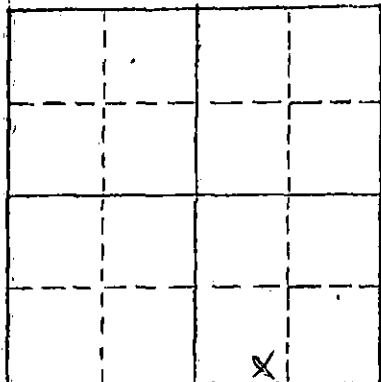

Locate well correctly on above  
Section Plat

If a producing well is abandoned, date of last production December 31 19 73  
Was permission obtained from the Conservation Division or its agents before plugging was com-  
menced? Yes

Name of Conservation Agent who supervised plugging of this well Russell Biberstein  
Producing formation Lansing-Kansas City Depth to top 3776 Bottom 2222 Total Depth of Well 4425 Feet  
Show depth and thickness of all water, oil and gas formations. 4094

OIL, GAS OR WATER RECORDS

CASING RECORD

FORMATION	CONTENT	FROM	TO	SIZE	PUT IN	PULLED OUT
				8 5/8"	825	None
				4 1/2"	4425	2692

Describe in detail the manner in which the well was plugged, indicating where the mud fluid was placed and the method or methods used in introducing it into the hole. If cement or other plugs were used, state the character of same and depth placed, from \_\_\_\_\_ feet to \_\_\_\_\_ feet for each plug set.

March 18, 1974 Plugged off bottom. Dumped sand to 3900'.  
Mixed and dumped 4 sx of cement.  
April 3, 1974 Plugged off top. Allied Cementing Co. mix-  
ed and pumped down 8 5/8" surface casing;  
3 sx of hulls, 15 sx of gel and 125 sx of  
cement.

RECEIVED  
STATE CORPORATION COMMISSION  
APR 12 1974  
CONSERVATION DIVISION  
Wichita, Kansas

(If additional description is necessary, use BACK of this sheet)  
Name of Plugging Contractor RUSS CASING PULLING, INC.  
Address P. O. Box 1082 ; Great Bend, Kansas 67530

STATE OF KANSAS COUNTY OF SEDGWICK  
Don Gardner

(owner or operator) or (owner or operator) of the above-described well, being first duly sworn on oath, says: That I have knowledge of the facts, statements, and matters herein contained and the log of the above-described well as filed and that the same are true and correct. So help me God.

(Signature) [Signature]  
Suite 250, 200 West Douglas, Wichita, Kans.  
(Address)

SUBSCRIBED AND SWORN to before me this 10th day of April 19 74

My commission expires December 14, 1977 [Signature] Notary Public.

# WELL LOG

COMPANY Dunne-Gardner Drilling Co., Inc.

SEC. 27 T. 26-S R. 13-W  
LOC. SE SW SE

FARM SOEKEN NO. 1

RIG. NO. 14

TOTAL DEPTH 4425'


COMM. 6-28-67 COMP. 7-12-67

SHOT OR TREATED

CONTRACTOR Murfin Drilling Company

ISSUED

COUNTRY Pratt  
KANSAS

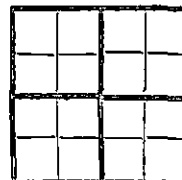

### CASING

20	10
15	5/8" 825' w/600 SX
12	6
13	1/2" 4425' w/200 SX

ELEVATION

PRODUCTION oil

FIGURES INDICATE BOTTOM OF FORMATIONS

- 40 Clay
- 100 Sand & Clay
- 200 Clay
- 280 Shale
- 822 Red Bed
- 825 Anhydrite
- 1199 Red Bed
- 1490 Shale
- 1940 Shale, Salt, Lime, Shells
- 2070 Shale
- 2685 Lime & Shale
- 2800 Shale & Lime
- 3654 Shale & Lime
- 3830 Lime & Shale
- 3935 Lime
- 3952 Lime & Shale Streaks
- 4172 Lime
- 4200 Chert
- 4246 Lime & Chert
- 4295 Chert & Lime
- 4309 Lime (Cherty)
- 4360 Simpson
- 4415 Lime & Shale
- 4425 Lime
- 4425 RTD

RECEIVED  
STATE CORPORATION COMMISSION  
MAR 18 1974  
CONSERVATION DIVISION  
Wichita, Kansas

State of Kansas  
County of Sedgwick } ss:

I, James R. Daniels of the Murfin Drilling Company

upon oath state that the above and foregoing is a true and correct copy of the log of the SOEKEN #1 well.

James R. Daniels  
James R. Daniels  
Subscribed and sworn to before me this 1st day of August 19 67

My Commission Expires: ADELA MIZENER, Notary Public  
My commission expires November 5, 1970

Adela Mizener  
NOTARY PUBLIC