

WELL PLUGGING RECORD

Give All Information Completely
Make Required Affidavit
Mail or Deliver Report to:
Conservation Division
State Corporation Commission
800 Biting Building
Wichita, Kansas

Pratt County, Sec. 22 Twp. 26 Rge. 13 (X) W (W)

Location as "NE/CNW%SW%" or footage from lines NE NE NW

Lease Owner A. G. Hill

Lease Name Repp Well No. 1

Office Address Wagstaff Building, Abilene, Texas

Character of Well (completed as Oil, Gas or Dry Hole) _____

Date well completed 6-18-1954

Application for plugging filed 6-18-1954

Application for plugging approved 6-18-1954


Plugging commenced 6-18-1954

Plugging completed 6-18-1954

Reason for abandonment of well or producing formation _____

If a producing well is abandoned, date of last production _____ 19__

Was permission obtained from the Conservation Division or its agents before plugging was commenced? Yes

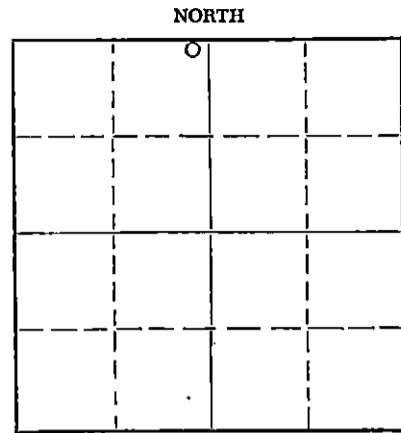

Locate well correctly on above Section Flat

Name of Conservation Agent who supervised plugging of this well G. D. Stough M. A. Rives

Producing formation _____ Depth to top _____ Bottom _____ Total Depth of Well 4475 Feet

Show depth and thickness of all water, oil and gas formations.

OIL, GAS OR WATER RECORDS

CASING RECORD

FORMATION	CONTENT	FROM	TO	SIZE	PUT IN	PULLED OUT
				8-5/8"	521	0

Describe in detail the manner in which the well was plugged, indicating where the mud fluid was placed and the method or methods used in introducing it into the hole. If cement or other plugs were used, state the character of same and depth placed, from _____ feet to _____ feet for each plug set.

Hole filled with heavy mud from Total depth to 300' - set plug at 300' and cemented with 20 sacks cement. Set top plug at 35' and cemented with 10 sacks cement.

(If additional description is necessary, use BACK of this sheet)

Name of Plugging Contractor Reserve Drilling Company, Inc.

Address 703 Union National Bank Bldg. Wichita 2, Kansas

STATE OF KANSAS, COUNTY OF SEDGWICK, ss.

L. C. Hay, Agent (Employee of owner) ~~(Operator)~~ of the above-described well, being first duly sworn on oath, says: That I have knowledge of the facts, statements, and matters herein contained and the log of the above-described well as filed and that the same are true and correct. So help me God.

(Signature) L. C. Hay

Wichita, Kansas (Address)

SUBSCRIBED AND SWORN TO before me this 18th day of June, 1954

My commission expires Nov. 3, 1956

Rola Bass Notary Public.

PLUGGING
FILE SEC 27 T 26 R 13W
BOOK PAGE 41 LINE 42

7-17-54

15-151-00353-0000

A. G. HILL

REPP No. 1

NE NE NW 27-26-13W
Pratt County, Kansas

Comm: 6-3-54
Comp: 6-17-54

Casing: 8-5/8" 521' w/250 sax

<u>Formations</u>	<u>Depth</u>
Sand and gravel	195
Red bed and shells	830
Anhydrite	870
Shale and shells	1100
Shale, shells and salt	1720
Shale and shells	1760
Lime and shale	2735
Shale and lime streaks	2915
Lime and shale	3435
Sandy lime and shale	3560
Lime and shale	4297
Lime and chert	4330
Cherty lime	4340
Cherty lime and sand	4360
Sand and shale	4390
Lime and shale	4475

STATE OF KANSAS)
) SS:
 COUNTY OF SEDGWICK)

Nola Babb, being first duly sworn, states that the above depths and formations are correct as shown by the daily drilling log of the Repp No. 1 Well in the NE NE NW 27-26-13W, Pratt County, Kansas.

Nola Babb

Subscribed and sworn to before me this 24th day of June, 1954.

Oliver Carter

My Comm. expires 3-21-55

7-17-54

CONSERVATION DIVISION
 Wichita, Kansas

PLUGGING
 FILE SEC 27-26-13W
 BOOK PAGE 41 LINE 42