


STATE OF KANSAS
STATE CORPORATION COMMISSION

Give All Information Completely.
Make Required Affidavit
Mail or Deliver Report to:
Conservation Division
State Corporation Commission
212 No. Market
Wichita, Kansas

WELL PLUGGING RECORD

Pratt County. Sec. 27 Twp. 26S Rge. (E) 13 (W)

Location as "NE/CNW/SW" or footage from lines SE NW SE
Lease Owner Imperial Oil Co.
Lease Name Hoener Well No. 2
Office Address 780 Fourth National Bldg., Wichita, Kansas
Character of Well (completed as Oil, Gas or Dry Hole) Dry Hole
Date well completed October 8 19 68
Application for plugging filed October 8 19 68
Application for plugging approved October 8 19 68
Plugging commenced October 8 19 68
Plugging completed October 8 19 68
Reason for abandonment of well or producing formation No commercial quantities of oil were encountered.
If a producing well is abandoned, date of last production 19
Was permission obtained from the Conservation Division or its agents before plugging was commenced? yes

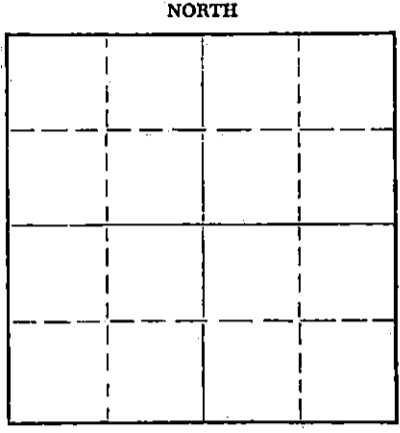

Locate well correctly on above Section Plat

Name of Conservation Agent who supervised plugging of this well Ralph J. Warren, Pratt, Kansas
Producing formation Depth to top Bottom Total Depth of Well 4408 Feet
Show depth and thickness of all water, oil and gas formations.

OIL, GAS OR WATER RECORDS

CASING RECORD

FORMATION	CONTENT	FROM	TO	SIZE	PUT IN	PULLED OUT
Surface casing			818'	8 5/8"	550 sacks	Not pulled

Describe in detail the manner in which the well was plugged, indicating where the mud fluid was placed and the method or methods used in introducing it into the hole. If cement or other plugs were used, state the character of same and depth placed, from 4408 feet to feet for each plug set.

Set first plug at 300 feet with 25 sacks cement.
Set second plug at 40 feet with 10 sacks cement.

10-17-68

RECEIVED
STATE CORPORATION COMMISSION
OCT 17 1968
CONSERVATION DIVISION
Wichita, Kansas

(If additional description is necessary, use BACK of this sheet)

Name of Plugging Contractor Imperial Oil Company
Address 780 Fourth National Bldg., Wichita, Kansas 67202

STATE OF KANSAS, COUNTY OF SEDGWICK, ss.
William A. Sladek (employee of owner) or (owner or operator) of the above-described well, being first duly sworn on oath, says: That I have knowledge of the facts, statements, and matters herein contained and the log of the above-described well as filed and that the same are true and correct. So help me God. IMPERIAL OIL COMPANY

(Signature) William A. Sladek
William A. Sladek
780 Fourth National Bldg., Wichita, Ks.
(Address)

SUBSCRIBED AND SWORN to before me this 16th day of October, 19 68

My commission expires March 3, 1970
Mary J. Brown Notary Public.

DRILLER'S LOG

15-151-20089-0000 *R*

Imperial Oil Company
780 Fourth National Bldg.
Wichita, Kansas

Hoener No. 2
SE NW SE Sec. 27-26S-13W
Pratt County, Kansas

Total Depth: 4408 ft.

Elevation: 1951 K.B.

Commenced: 9-24-68

Completed: 10-8-68
Dry Hole

Contractor: Imperial Oil Co., Rig #2

Casing Record: Set 8 5/8" surface casing at 818 ft. with 550 sacks of cement.

Figures indicate bottom of formations:

		<u>Sample Tops</u>	
200'	Sand	Anhydrite	809 (+1142)
320'	Shale-sand	Heebner	3605 (-1654)
909'	Shale-Red bed	Toronto	3629 (-1678)
926'	Anhydrite	Douglas Sand	3677 (-1726)
1065'	Shale	Brown Lime	3771 (-1820)
1680'	Lime-shale	Lansing	3797 (-1846)
2015'	Shale	Marmaton Chert	4149 (-2198)
2210'	Shale-lime	Mississippi	4207 (-2256)
2600'	Lime-shale	Viola	4288 (-2337)
2850'	Shale	Simpson Dolomite	4364 (-2413)
2940'	Lime-shale	Total Depth	4408 (-2457)
3110'	Shale-lime		
3510'	Lime-shale		
3665'	Lime	4310' Chert	
3805'	Lime-shale	4355' Lime-chert	
4171'	Lime	4405' Lime	
4290'	Lime-chert	4408' Lime-sand	
		<u>4408' Rotary Total Depth</u>	

Reed
10-17-68

We hereby certify this to be a correct and accurate log of the above described well, as shown on the daily drilling reports.

IMPERIAL OIL COMPANY

By *William A. Sladek*
William A. Sladek

Subscribed and sworn to before me this 14th day of October, 1968.

Mary J. Brown
Mary J. Brown, Notary Public

My Commission Expires:
March 3, 1970