

STATE OF KANSAS
STATE CORPORATION COMMISSION

Form CP-4

WELL PLUGGING RECORD

Give All Information Completely
Make Required Affidavit
Mail or Deliver Report to:
Conservation Division
State Corporation Commission
212 No. Market
Wichita, Kansas

Pratt County, Sec. 27 Twp. 21S Rge. 12 (E) (W)

Location as "NE/CNW/SW" or footage from lines N/2 NE SW

Lease Owner ~~Leben Drilling, Inc.~~ Explorer Oil Company

Lease Name Hoener Well No. 1

Office Address ~~Great Bend, Kansas~~ 2717 1st Nat'l Bk. Bldg. Okla. City Okla.

Character of Well (completed as Oil, Gas or Dry Hole) Dry Hole

Date well completed 12-22-65 19

Application for plugging filed 12-22-65 19

Application for plugging approved 12-22-65 19


Plugging commenced 12-22-65 19

Plugging completed 12-22-65 19

Reason for abandonment of well or producing formation Running low structurally

If a producing well is abandoned, date of last production 19

Was permission obtained from the Conservation Division or its agents before plugging was commenced? yes

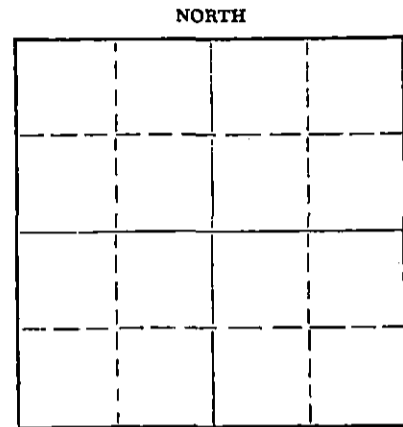

Locate well correctly on above Section Plat

Name of Conservation Agent who supervised plugging of this well Archie Elving

Producing formation Depth to top Bottom Total Depth of Well Feet

Show depth and thickness of all water, oil and gas formations.

OIL, GAS OR WATER RECORDS

CASING RECORD

FORMATION	CONTENT	FROM	TO	SIZE	PUT IN	PULLED OUT
Anhydrite		1621	1633	8-5/8"	295'	

Describe in detail the manner in which the well was plugged, indicating where the mud fluid was placed and the method or methods used in introducing it into the hole. If cement or other plugs were used, state the character of same and depth placed, from feet to feet for each plug set.

mud to 260 ft. wooden plug set. 1/4 sack hulls and 25 sacks cement.

Mud to 40 ft. Wooden plug set. 1/2 sack hulls and 10 sacks cement.

12-27-65

RECEIVED
STATE CORPORATION COMMISSION

DEC 27 1965

CONSERVATION DIVISION
Wichita, Kansas

Name of Plugging Contractor Leben Drilling, Inc.
Address Box 486 Great Bend, Kansas

STATE OF KANSAS, COUNTY OF BARTON, ss.
Jack M. Dunham (employee of owner) or (owner) of the above-described well, being first duly sworn on oath, says: That I have knowledge of the facts, statements, and matters herein contained and the log of the above-described well as filed and that the same are true and correct. So help me God.

(Signature) Jack M. Dunham

(Address)

SUBSCRIBED AND SWORN to before me this 22nd day of December, 19 65

My commission expires January 24, 1968.

Dorothy Tully
Dorothy Tully
Notary Public.

D R I L L E R S L O G

#1 Hoener

CASING RECORD: 15 Jts. 8-5/8" 295'

COMPANY: ~~Explorer Oil Company~~ ~~Aspen Drilling Co.~~ ~~Pratt Co., Kansas~~

CONTRACTOR: Aspen Drilling Co.

DESCRIPTION: N/2 NE SW Sec. 27-T26S-R13W Pratt Co., Kansas

TOTAL DEPTH: 3187'

COMMENCED: 12-16-65

ELEVATION: 1944 KB 1942 DF

COMPLETED: 12-22-65

<u>Formation</u>	<u>From</u>	<u>To</u>	<u>Remarks</u>
Surface Soil & Sand	0	40	Spudded at 10:30 P.M. 12-17-65.
Sand & Shale	40	190	Ran 15 Jts. 8-5/8" 295' O.D. used
Redbed & Shells	305	997	28# casing. Set @ 302'. Cemented
Redbed & Shells	997	1205	with 225 sxs 60-40 pozmix with 2%
Blue Shale	1205	1295	Gel and 3% HA5. Plug down @ 4:15
Shale	1295	1621	P.M. 12-18-65. Cement circulated.
Anhydrite	1621	1633	
Shale & Shell	1633	1850	No Drill Stem Tests
Shale & Lime Streaks	1850	2128	
Shale & Lime	2128	2211	No Log
Lime & Shale	2211	2595	
Shale & Shells	2595	3030	RTD 3187' D & A.
Lime & Shale	3030	3187	
T.D.	3187		

Sample Tops

Anhydrite	1621
-----------	------

12-27-65

RECEIVED
STATE CORPORATION COMMISSION
DEC 27 1965
CONSERVATION DIVISION
Topeka, Kansas

STATE OF KANSAS

SS

COUNTY OF BARTON

The undersigned, being duly sworn on oath, states that the above statement and log are true and a correct record and log of the well drilled at the location above described.

Jack M. Dunham
Jack M. Dunham, Tool Pusher