


Give All Information Completely
Make Required Affidavit
Mail or Deliver Report to:
Conservation Division
State Corporation Commission
211 No. Broadway
Wichita, Kansas

WELL PLUGGING RECORD

Pratt County, Sec. 27 Twp. 26S Rge. 13W (E) (W)

Location as "NE/CNW&SW&W" or footage from lines. C NW NW
Lease Owner Martin & Keller
Lease Name Repp Well No. 1
Office Address 1035 Kennedy Bldg., Tulsa, Okla. 74103
Character of Well (completed as Oil, Gas or Dry Hole) Dry Hole
Date well completed 5-24-65 19
Application for plugging filed 5-24-65 19
Application for plugging approved 5-24-65 19
Plugging commenced 5-24-65 19
Plugging completed 5-24-65 19
Reason for abandonment of well or producing formation Dry Hole

NORTH

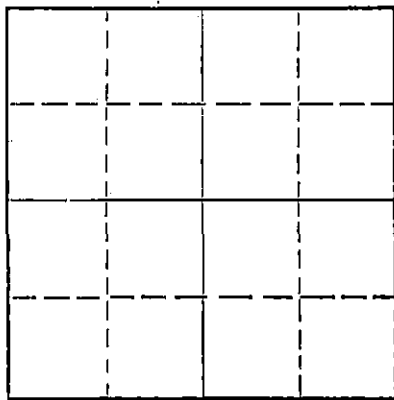

Locate well correctly on above
Section Plat

If a producing well is abandoned, date of last production 19
Was permission obtained from the Conservation Division or its agents before plugging was commenced? yes

Name of Conservation Agent who supervised plugging of this well Archie Elving, Pratt, Kansas
Producing formation _____ Depth to top _____ Bottom _____ Total Depth of Well 4447 Feet
Show depth and thickness of all water, oil and gas formations.

OIL, GAS OR WATER RECORDS

CASING RECORD

FORMATION	CONTENT	FROM	TO	SIZE	PUT IN	PULLED OUT
				8 5/8"	305'	none

Describe in detail the manner in which the well was plugged, indicating where the mud fluid was placed and the method or methods used in introducing it into the hole. If cement or other plugs were used, state the character of same and depth placed, from _____ feet to _____ feet for each plug set.

Plug @ 275' with 20 sk. cmnt.
Bridged plug @ 40' with 1/2 sk. hulls 10 sks. cmnt.
2 sks. cmnt in rathole

5-27-65

RECEIVED
STATE CORPORATION COMMISSION

MAY 27 1965

CONSERVATION DIVISION
Wichita, Kansas

(If additional description is necessary, use BACK of this sheet)

Name of Plugging Contractor Leben Drilling, Inc.
Address Box 486, Great Bend, Kansas 67530

STATE OF KANSAS, COUNTY OF BARTON, ss.
Leslie Kite (employee of owner) or (owner or operator) of the above-described well, being first duly sworn on oath, says: That I have knowledge of the facts, statements, and matters herein contained and the log of the above-described well as filed and that the same are true and correct. So help me God.

(Signature) Leslie Kite
Box 486, Great Bend, Kansas
(Address)

SUBSCRIBED AND SWORN TO before me this 26th day of May, 19 65

My commission expires April 1, 1967

Wanda Nichols
Notary Public.

DRILLER'S LOG

COMPANY: Martin & Keller
 CONTRACTOR: LEBEN DRILLING, INC.
 FARM: REPP #1
 LOCATION: C NW NW Sec. 27-26S-13W
 PRATT COUNTY, KANSAS
 COMMENCED: 5-14-65
 COMPLETED: 5-24-65

0	30	Sand & Clay
30	185	Sand
185	305	Red Rock
305	480	Red Shale
480	897	Red Rock Sand
897	1640	Shale & Shells
1640	1775	Shale
1775	2050	Shale & Lime
2050	2445	Lime & Shale
2445	2670	Shale & Lime
2670	3125	Lime & Shale
3125	3375	Shale & Lime
3375	4275	Lime
4275	4375	Lime & Chert
4375	4447	Lime
	4447	<u>RTD - D. & A.</u>

RECEIVED
 STATE CORPORATION COMMISSION

MAY 27 1965
 5-27-65
 CONSERVATION DIVISION
 Wichita, Kansas

Set 8 5/8" used surface casing @ 305' with 250 sacks 60-40 Posmix 3% Sunset 2% Gel

I, Leslie Kite, do hereby certify that the above and foregoing is a true and correct copy of the log of the Repp #1 well, located C NW NW of Section 27, Township 26 South, Range 13 West, Pratt County, Kansas, as reflected by the records of Leben Drilling, Inc.

Leslie Kite

 Leslie Kite

STATE OF KANSAS)
) SS
 COUNTY OF BARTON)

Subscribed and sworn to before me, a Notary Public, in and for Barton County, Kansas, this 26th day of May, 1965.

Ulanda Nichols

 Ulanda Nichols

My Commission Expires
 April 1, 1967