


STATE OF KANSAS
STATE CORPORATION COMMISSION

Give All Information Completely
Make Required Affidavit
Mail or Deliver Report to:
Conservation Division
State Corporation Commission

WELL PLUGGING RECORD

P. O. Box 17027
Wichita, Kansas 67217
NORTH

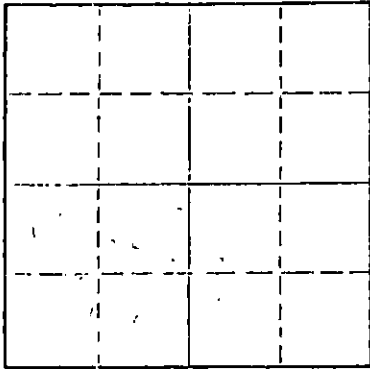

Locate well correctly on above
Section Plot

Pratt County, Sec. 32 Twp. 26 Rge. 13 (E) (W) X
Location as "NE/CNW/SE/SW" or footage from lines SE SW NE
Lease Owner Earl Allen Oil Co.
Lease Name Tregallas Well No. #2
Office Address Box 339 Great Bend, Kansas
Character of Well (completed as Oil, Gas or Dry Hole)
Date well completed 19
Application for plugging filed 19
Application for plugging approved 19
Plugging commenced 1-3-75 19
Plugging completed 1-7-75 19
Reason for abandonment of well or producing formation
If a producing well is abandoned, date of last production 19
Was permission obtained from the Conservation Division or its agents before plugging was commenced?

Name of Conservation Agent who supervised plugging of this well G. R. Biberstein
Producing formation Depth to top Bottom Total Depth of Well 4296' Feet
Show depth and thickness of all water, oil and gas formations.

OIL, GAS OR WATER RECORDS

CASING RECORD

FORMATION	CONTENT	FROM	TO	SIZE	PUT IN	PULLED OUT
				5 1/2"	4267'	1964.96'
				10 3/4"	849'	

Describe in detail the manner in which the well was plugged, indicating where the mud fluid was placed and the method or methods used in introducing it into the hole. If cement or other plugs were used, state the character of same and depth placed, from feet to feet for each plug set.

Made bottom hole plug back with sand to 4250'. Mixed and ran 5 sacks cement thru dump bailer.
Mudded hole to 275' - set 20' rock bridge. Filled hole with 5 1/2" yards ready-mix concrete.

(If additional description is necessary, use BACK of this sheet)

Name of Plugging Contractor Southwest Casing Pulling Co.
Address Box 364 Great Bend, Kansas

STATE OF Kansas, COUNTY OF Barton, ss.
Southwest Casing Pulling Co. (employee of owner) or (owner or operator) of the above-described well, being first duly sworn on oath, says: That I have knowledge of the facts, statements, and matters herein contained and the log of the above-described well as filed and that the same are true and correct. So help me God.

(Signature) W. C. Spencer Sec
Box 364 Great Bend, Kansas
(Address)



Subscribed and sworn to before me this 10 day of January, 1975

Sidney D. Miller
Notary Public.

RECEIVED
STATE CORPORATION COMMISSION

JAN 13 1975

CONSERVATION DIVISION
Wichita, Kansas

1-13-75

Wichita Te
480

339
or
336

15-151-10804-0000

W E L L L O G

CONTINENTAL OIL CO.

Described as your Tregollis
#2 Well, located in Pratt
County, Kansas

FROM	TO	FORMATION
0	428	<i>water</i> Sand & shale
428	770	Red Bed & shells
770	920	Red Bed & shale
920	1025	Shale & shells
1025	1590	Shale & shells
1590	1800	Shale & shells
1800	1935	Lime
1935	2100	Lime
2100	2221	Lime
2221	2300	Lime
2300	2435	Lime & shale
2435	2563	Lime & shale
2563	2680	Lime & shale
2680	2790	Broken Lime
2790	2996	Shale & lime
2996	3113	Shale & lime
3113	3170	Broken lime
3170	3264	Lime
3264	3355	Lime
3355	3415	Lime
3415	3493	Lime
3493	3660	Lime
3660	3712	Broken lime
3712	3768	Lime & shale
3768	3832	Lime & shale
3832	3891	Shale & lime
3891	3929	Lime
3929	3973	Lime
3973	4004	Lime
4004	4028	Lime
4028	4068	Lime
4068	4243	Lime
4243	4274	Lime & shale
4274		Total Depth

RECEIVED
STATE CORPORATION COMMISSION
DEC 16 1974
CONSERVATION DIVISION
Wichita, Kansas

12-16-74