

STATE OF KANSAS
STATE CORPORATION COMMISSION

WELL PLUGGING RECORD


Give All Information Completely
Make Required Affidavit
Mail or Deliver Report to:
Conservation Division
State Corporation Commission
800 Bitting Building
Wichita, Kansas

Pratt

County. Sec. 32 Twp. 26 Rge. (E) 13 (W)

Location as "NE/CNW%SW%" or footage from lines NE SE SW
Lease Owner Globe Oil & Refining Co.
Lease Name Hoener Well No. 1
Office Address 301 South Market, Wichita, Kansas
Character of Well (completed as Oil, Gas or Dry Hole) Dry Hole
Date well completed October 25, 1956
Application for plugging filed (Verbal 10-25-56) November 6, 1956
Application for plugging approved (Verbal 10-25-56) October 29, 1956
Plugging commenced October 25, 1956
Plugging completed October 25, 1956
Reason for abandonment of well or producing formation Dry Hole

NORTH

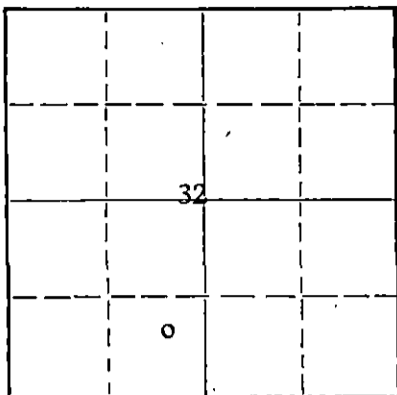

Locate well correctly on above
Section Plat

If a producing well is abandoned, date of last production _____ 19____
Was permission obtained from the Conservation Division or its agents before plugging was commenced? Yes

Name of Conservation Agent who supervised plugging of this well M. M. Rives, Pratt, Kansas
Producing formation _____ Depth to top _____ Bottom _____ Total Depth of Well 4500 Feet
Show depth and thickness of all water, oil and gas formations.

OIL, GAS OR WATER RECORDS

CASING RECORD

FORMATION	CONTENT	FROM	TO	SIZE	PUT IN	PULLED OUT
				8 5/8	871'	None

Describe in detail the manner in which the well was plugged, indicating where the mud fluid was placed and the method or methods used in introducing it into the hole. If cement or other plugs were used, state the character of same and depth placed, from _____ feet to _____ feet for each plug set.

Set plug at 300' and used 20 sacks cement down drill pipe.
Set plug at 35' and used 10 sacks cement to base of cellar.

(If additional description is necessary, use BACK of this sheet)

Name of Plugging Contractor Group Exploration Company
Address Sterling, Kansas

STATE OF Kansas, COUNTY OF Sedgwick, ss.
Leo Ross (employee of owner) or (owner or operator) of the above-described well, being first duly sworn on oath, says: That I have knowledge of the facts, statements, and matters herein contained and the log of the above-described well as filed and that the same are true and correct. So help me God.

(Signature) Leo Ross
301 South Market, Wichita, Kansas
(Address)

SUBSCRIBED AND SWORN TO before me this 26th day of November 1956

Leslie
STATE CORPORATION COMMISSION
Notary Public.

My commission expires July 21, 1958

PLUGGING
FILE SEC 32 T. 26 R. 13W
BOOK PAGE 111 LI. E. 10

NOV 13 1956

11-13-56

GLOBE OIL & REFINING CO.
Hoener No. 1
NE SE SW Sec. 32-26S-13W
Pratt County, Kansas

Date Commenced: 10-8-56
Date Completed: 10-25-56
Drilling Contractor: Group Exploration Co.
Total Depth - 4500'
I.P. - Dry and Abandoned

Casing Record:
8 5/8" 871' Set @ 862'
Cem. 550 sacks

Formation	Depth
Sand	210
Sandy red clay	300
Red rock	845
Shells	855
Anhydrite	885
Red bed	1120
Shale & shells	1555
Shale	1700
Shale & lime	2165
Lime	2335
Lime & shale	2430
Lime	2530
Lime & shale	3085
Lime	3200
Shale & lime	3375
Lime	3575
Shale & lime	3705
Shale & sand	3815
Lime	4150
Lime & shale	4200
Lime	4238
Lime & shale	4280
Shale & conglomerate	4305
Chert	4320
Mississippi	4345
Mississippi Chert	4368
Lime	4385
Shale & Viola chert	4436
Viola lime	4442
Shale & sand	4500

Geological Tops - K.B. Meas.	
Heebner	3666 (-1691)
Brown Lime	3812 (-1837)
Lansing	3837 (-1862)
Base K.C.	4154
Marion Cherty Lime	4193
Mississippian	4305 (-2330)
Kinderhook	4336 (-2361)
Viola	4397 (-2422)
Simpson	4438 (-2463)

11-13-56

RECEIVED
STATE CORPORATION COMMISSION

NOV 13 1956
CONSERVATION DIVISION
Wichita, Kansas

PLUGGING
FILE SEC 32 T 26 R 13W
BOOK PAGE 111 LINE 10