


STATE OF KANSAS  
STATE CORPORATION COMMISSION

WELL PLUGGING RECORD

Give All Information Completely  
Make Required Affidavit  
Mail or Deliver Report to:  
Conservation Division  
State Corporation Commission  
800 Bitting Building  
Wichita, Kansas

Pratt County, Sec. 32 Twp. 26S Rge. 13W (E) (W)

Location as "NE/CNW/SW" or footage from lines NE NE SE  
Lease Owner The Texas Company  
Lease Name J. B. Chance Well No. 2  
Office Address 614 Bitting Building, Wichita, Kansas  
Character of Well (completed as Oil, Gas or Dry Hole) Oil  
Date well completed September 27 19 50  
Application for plugging filed August 15 19 55  
Application for plugging approved August 16 19 55  
Plugging commenced August 23 19 55  
Plugging completed August 24 19 55  
Reason for abandonment of well or producing formation Ceased to be a commercial producer

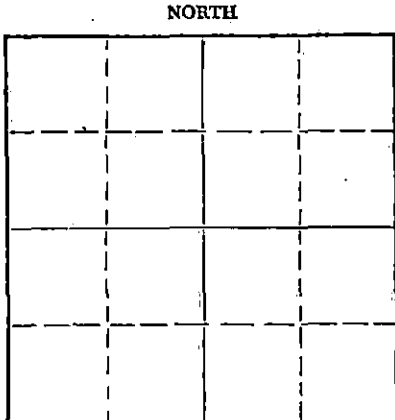

Locate well correctly on above Section Plat

If a producing well is abandoned, date of last production July 12 19 55  
Was permission obtained from the Conservation Division or its agents before plugging was commenced? Yes

Name of Conservation Agent who supervised plugging of this well Mr. M. A. Rives  
Producing formation Lansing Depth to top 3961 Bottom 3968 Total Depth of Well 4444 Feet  
Show depth and thickness of all water, oil and gas formations. PBTD 3865

OIL, GAS OR WATER RECORDS

CASING RECORD

FORMATION	CONTENT	FROM	TO	SIZE	PUT IN	PULLED OUT
				10-3/4"	853'	0'
				7"	4430'	2651'

Describe in detail the manner in which the well was plugged, indicating where the mud fluid was placed and the method or methods used in introducing it into the hole. If cement or other plugs were used, state the character of same and depth placed, from \_\_\_\_\_ feet to \_\_\_\_\_ feet for each plug set.

PLUGGED AS FOLLOWS:

3865' to 3815' - Sand  
3815' to 3795' - 5 Sacks Cement.  
3795' to 225' - 115 Sacks Heavy Mud followed by 20 Sacks Cement  
225' to Bottom of Cellar - Heavy Mud

Name of Plugging Contractor R & S Pipe Pulling Company (If additional description is necessary, use BACK of this sheet.)  
Address Box 192, Ellinwood, Kansas

STATE OF Kansas COUNTY OF Sedgwick ss.  
M. C. Harrell (employee of owner) or (owner or operator) of the above-described well, being first duly sworn on oath, says: That I have knowledge of the facts, statements and matters herein contained and the log of the above-described well as filed and that the same are true and correct. So help me God.

(Signature) M. C. Harrell  
614 Bitting Building, Wichita, Kansas (Address)

SUBSCRIBED AND SWORN TO before me this 26th day of August, 19 55

My commission expires September 20, 1956

H. Howard Kistler Notary Public.

RECEIVED  
STATE CORPORATION COMMISSION

AUG. 30 1955 8-30-55

CONSERVATION DIVISION  
Wichita, Kansas

PLUGGING  
PLR SEC 32 T 26 R 32 W  
BOOK PAGE 143 LINE 1

# LOG OF WELL

Form PO-214 Sheet 11-1-1-4M

J. B. Chance #2

SHEET 1

OWNER The Texas Company, Oklahoma DATE MADE November 21, 1950  
 DISTRICT Kansas EAST OF L. Chance WELL NO. 2  
 STATE Kansas COUNTY OR PARISH Pratt TWP. 26S RANGE 13W SEC. 32  
 LOCATION OF WELL NE NE SE

COMMENCED RIGGING UP 7-28-50 COMMENCED DRILLING 7-28-50 COMPLETED DRILLING 9-4-50  
 DAY DRILLER NIGHT DRILLER CONTRACTOR Stickle Drlg. Co.  
 CABLE FROM 4432' TO 4444' ROTARY FROM TO 4432' COMPANY RIG NO.  
 TOTAL DEPTH 4444' MEASURED BY M. C. Harrell ELEVATION 1966' KB  
 1964' DF  
 1961' GL

## CASING RECORD

SIZE	WEIGHT	PUT IN WELL		PULLED OUT		LOST IN WELL		SHOES		PACKERS		
		FEET	INS.	FEET	INS.	FEET	INS.	LENGTH	MAKE	KIND	LENGTH	SET AT
10-3/4"	32.75#	853										FT.
7"	20#	4430										FT.
												FT.
												FT.
10-3/4" csg set at 853' with 600 sacks Universal Atlas cmt & 2 sax CC												FT.
7" casing set at 4430' with 175 sacks Monarch Portland Cement												FT.
												FT.
												FT.

WAS CASING CEMENTED? IF SO, HOW MANY SACKS OF CEMENT USED?  
 LINER: STATE SIZE AND WEIGHT, WHERE SET, FT. AND INS. BLANK, FT. AND INS. PERFORATED.  
 HOW PUT TOGETHER, COUPLING, FLUSH-JOINT, INSERTED.  
 REMARKS:

## EQUIPMENT RECORD

TUBING			SUCKER RODS			PUMPING OUTFIT
SIZE	WEIGHT	FEET	INS.	FEET	INS.	DESCRIPTION, KIND, SIZE, ETC.

Completed Testing 9-27-50  
 FLOWING, PUMPING, GASSER OR DRY. Pumping PRODUCTION FIRST 24 HOURS 85 bbl oil, 35 bbl water PRODUCTION SETTLED  
 IF GAS WELL, OPEN FLOW CAPACITY SHUT IN PRESSURE ROCK PRESSURE  
 KIND OF SHOT, SIZE OF SHOT, QUARTS  
 NUMBER OF SHELLS, SIZE OF SHELLS, INCHES, DIAMETER  
 LENGTH OF SHELLS, FEET, INCHES, TOP OF SHOT  
 BOTTOM OF SHOT, ANCHOR, WELL BRIDGED TO  
 TOTAL DEPTH OF WELL, NUMBER OF SHOT, PRODUCTION BEFORE SHOT, BBL. PER DAY  
 PRODUCTION AFTER SHOT, BBL. PER DAY, SHOT FURNISHED BY  
 NAME OF SHOOTER, SHOT INSPECTED BY, (COMPANY EMPLOYEE)  
 COMMENCED DRILLING DEEPER, COMPLETED, DRILLING DEEPER  
 TOTAL DEPTH, PRODUCTION FIRST 24 HOURS, PRODUCTION SETTLED

8-30-55

**PLUGGING**  
 FILE SEC 32 T 26 R 13W  
 BOOK PAGE 143 LINE 1

J. B. Chance #2  
 Total Depth-----4444'  
 Comp. Drig-----9-4-50  
 Comp. Tstg-----9-27-50

NOTE: IF WELL WAS DRY, STATE UNDER REMARKS, WHEN, HOW, AND BY WHOM PLUGGED.  
 STATE UNDER REMARKS ANYTHING OF INTEREST NOT COVERED IN LOG.  
 IF THE SPACE PROVIDED FOR REMARKS IS NOT SUFFICIENT WRITE ON BOTTOM OF LAST SHEET OF LOG.

## LOG OF WELL

SHEET NO. 2

District	Owner	Trac	Co.	Land	D. C.	ance	Well No.
FORMATION	AMOUNT	COLOR	HARDNESS	DEPTH	LOGS	FEET	REMARKS
Shale & shells	40						GASING RECORD
Sand	137						10-3/4" csg set at
Sand	167						853' w/600 sack Univer-
Shale & shells	479	250					sol Atlas cnt & 2 sack
Sandy shale	560	10					CC.
Red Bed	645	"					7" csg set at 4430'
Red Bed & shells	845	10					w/175 sacks Monarch
Anhydrite	870	25					Portland Cement
Shale & shells	1470	600					
Salt and shale	1610	140					ELEVATION:
Shale	1775	165					1966' KB
Broken lime	1930	155					1964' DF
Lime	2000	70					1961' GL
Bro Lime	2135	135					TOPS:
Lime	2245	110					Stone Corral-----342
Shale & lime	2360	115					Hebner-----362
Lime	2590	230					Brown Lansing-----377
Lime & shale	2875	285					Lansing-----379
Shale & lime	2980	105					Mississippian-----415
Lime & shale	3055	75					Kinderhook-----425
Shale & lime	3310	255					Viola-----435
Lime & shale	3368	58					Simpson-----445
Shale	3480	112					Arbuckle-----455
Shale & shells	3580	100					
Shale & lime	3660	80					
Lime	4257	597					
Cherty Lime	4273	16					
Lime & chert	4291	18					
Lime	4341	50					
Shale	4349	8					
Sand	4362	13					
Simpson Sand	4369	7					
Lime	4444	75					
TOTAL DEPTH	4444'						

