


STATE OF KANSAS
STATE CORPORATION COMMISSION

Form CP-4

Give All Information Completely
Make Required Affidavit
Mail or Deliver Report to:
Conservation Division
State Corporation Commission
212 No. Market
Wichita, Kansas

WELL PLUGGING RECORD

NORTH

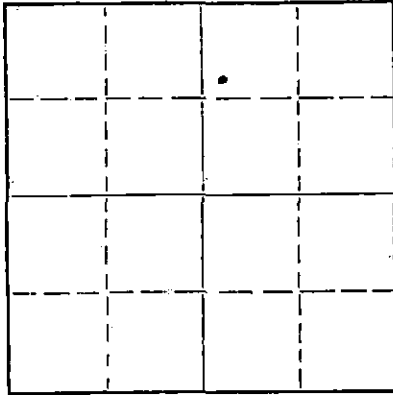

Locate well correctly on above
Section Plat

Pratt County, Sec. 33 Twp. 26 Rge. (E) 13 (W)
Location as "NE/CNW/SW" or footage from lines SW NW NE
Lease Owner West Supply Company
Lease Name Galbeck Well No. 2
Office Address Box 327, Chase, Kansas
Character of Well (completed as Oil, Gas or Dry Hole) oil
Date well completed April 29 1949
Application for plugging filed June 3 1966
Application for plugging approved June 6 1966
Plugging commenced July 29 1966
Plugging completed August 16 1966
Reason for abandonment of well or producing formation depleted

If a producing well is abandoned, date of last production 19
Was permission obtained from the Conservation Division or its agents before plugging was commenced? YES

Name of Conservation Agent who supervised plugging of this well Archie Elving
Producing formation _____ Depth to top _____ Bottom _____ Total Depth of Well 4417 1/2 Feet
Show depth and thickness of all water, oil and gas formations.

OIL, GAS OR WATER RECORDS

CASING RECORD

| FORMATION | CONTENT | FROM | TO | SIZE | PUT IN | PULLED OUT |
|-----------|---------|------|----------|--------|----------|------------|
| | | 0 | 811' | 8 5/8" | 811' | none |
| | | 0 | 441 1/2' | 5 1/2" | 441 1/2' | 2103.11 |
| | | | | | | |
| | | | | | | |
| | | | | | | |
| | | | | | | |
| | | | | | | |

Describe in detail the manner in which the well was plugged, indicating where the mud fluid was placed and the method or methods used in introducing it into the hole. If cement or other plugs were used, state the character of same and depth placed, from _____ feet to _____ feet for each plug set.

Pushed plug to 4317 1/2', set 10' rock bridge and dumped 5 sacks of cement at 4307 1/2'.
Pushed plug to 325'. Set 10' rock bridge. Mixed 4 sacks of cement and dumped on bridge. Let set over night. Bailed hole down and dumped 21 sacks of cement. Filled hole with mud to 40', set 10' rock bridge and capped hole with 10 sacks of cement.

8-26-66

RECEIVED
STATE CORPORATION COMMISSION

AUG 26 1966

CONSERVATION DIVISION
Wichita, Kansas

(If additional description is necessary, use BACK of this sheet)

Name of Plugging Contractor Pipe Pullers, Inc.
Address Box 486, Ellinwood, Kansas

STATE OF Kansas, COUNTY OF Barton, ss.
Dean Wells (employee of owner) or (~~owner or operator~~) of the above-described well, being first duly sworn on oath, says: That I have knowledge of the facts, statements, and matters herein contained and the log of the above-described well as filed and that the same are true and correct. So help me God.

(Signature) Dean Wells
Ellinwood, Kansas
(Address)

SUBSCRIBED AND SWORN TO before me this 22nd day of August, 1966

My commission expires July 7, 1968

[Signature]
Notary Public.

WELL LOG BUREAU - KANSAS GEOLOGICAL SOCIETY
412 Union National Bk. Bldg., Wichita, Kansas


COPY

Company - DEEP ROCK OIL CORPORATION
Farm - Calbeck No. 2

SEC. 33 T. 26 R. 13W
SW NW NE

Total Depth. 4418
Comm. 3-18-49 Comp. 4-29-49
Shot or Treated.
Contractor. Rine Drilling Co.
Issued. 5-28-49

County. Pratt
KANSAS

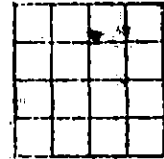

Elevation. _____

Production. Pot. 75 BOPD

CASING:

8 5/8" 811'
5 1/2" 4412

Figures Indicate Bottom of Formations.

| | |
|--------------------|------|
| sand, red bed | 528 |
| shalt, sand | 985 |
| shale, shells | 1790 |
| shale, lime | 1955 |
| shale | 2330 |
| lime | 2440 |
| shale, lime | 2600 |
| shale, shells | 2940 |
| shale, lime | 3195 |
| shale | 3375 |
| shale, shells | 3510 |
| lime brkn | 3595 |
| shale, lime | 3680 |
| sand | 3705 |
| lime | 4160 |
| lime, chert | 4175 |
| shale, lime, chert | 4220 |
| shale, chert | 4257 |
| lime, shale | 4310 |
| chert | 4312 |
| shale, chert | 4322 |
| shale | 4337 |
| sand, shale | 4350 |
| shale, lime | 4415 |
| lime | 4418 |
| Total depth | |

Tops:

| | |
|----------|------|
| Lansing | 3773 |
| Viola | 4247 |
| Simpson | 4318 |
| Arbuckle | 4412 |

RECEIVED
STATE CORPORATION COMMISSION
AUG 26 1966
CONSERVATION DIVISION
Wichita, Kansas