

STATE OF KANSAS  
STATE CORPORATION COMMISSION


Give All Information Completely  
Make Required Affidavit  
Mail or Deliver Report to:  
Conservation Division  
State Corporation Commission  
212 No. Market  
Wichita, Kansas

WELL PLUGGING RECORD

Pratt County, Sec. 33 Twp. 26S Rge. (E) 13 (W)

Location as "NE/CNW/SW" or footage from lines NE SE NE  
Lease Owner General American Oil Company of Texas  
Lease Name Calbeck Well No. 7  
Office Address P.O. Box 1358, Seminole, Oklahoma 74868  
Character of Well (completed as Oil, Gas or Dry Hole) oil  
Date well completed 19  
Application for plugging filed July 18 19 68  
Application for plugging approved 19  
Plugging commenced July 27 19 68  
Plugging completed August 5 19 68  
Reason for abandonment of well or producing formation depleted

NORTH

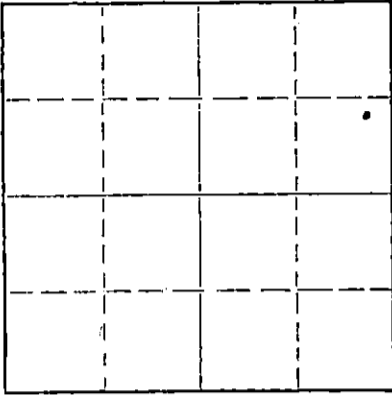

Locate well correctly on above  
Section Plat

If a producing well is abandoned, date of last production 19  
Was permission obtained from the Conservation Division or its agents before plugging was com-  
menced? yes

Name of Conservation Agent who supervised plugging of this well Ralph Warren  
Producing formation Depth to top Bottom Total Depth of Well 4383 Feet  
Show depth and thickness of all water, oil and gas formations.

OIL, GAS OR WATER RECORDS

CASING RECORD

FORMATION	CONTENT	FROM	TO	SIZE	PUT IN	PULLED OUT
		0	833'	10 3/4"	833'	none
		0	4406'	7"	4406'	2762.66

Describe in detail the manner in which the well was plugged, indicating where the mud fluid was placed and the method or methods used in introducing it into the hole. If cement or other plugs were used, state the character of same and depth placed, from feet to feet for each plug set.

Pushed plug to 3200'; set 10 gal. rock and 15 gal. sand bridge.  
Dumped 5 sacks cement.

Pushed plug to 300', set 10' rock bridge and dumped 5 sacks cement.  
Bailed down hole and dumped 35 sacks cement. Filled hole with mud  
to 20' and capped hole with 10 sacks cement.

RECEIVED  
STATE CORPORATION COMMISSION  
AUG 22 1968  
CONSERVATION DIVISION  
Wichita, Kansas

(If additional description is necessary, use BACK of this sheet)  
Name of Plugging Contractor Pipe Pullers, Inc.  
Address Box 486, Ellinwood, Kansas

STATE OF Kansas, COUNTY OF Barton, ss.  
Evelyn Roth (employee of owner) or (owner or operator) of the above-described well, being first duly sworn on oath, says: That I have knowledge of the facts, statements, and matters herein contained and the log of the above-described well as filed and that the same are true and correct. So help me God.

(Signature) Evelyn Roth  
Ellinwood, Kansas  
(Address)

SUBSCRIBED AND SWORN TO before me this 20th day of August 19 68

George A. Meyer  
Notary Public.

My commission expires Feb. 10, 1971

DRILLER'S LOG - CALBECK #7

Surface dirt & sand	0	100
Sand & red bed	100	450
Red bed & red rock	450	829
Anhydrite	829	835
Sand & shale	835	1010
Shale & shells	1010	1500
Shale & salt	1500	1800
Shale & sandy lime	1800	1930
Lime & shale	1930	2085
Sand lime shale	2085	2250
Shale lime	2250	2505
Shale	2505	3470
Shale & lime	3470	4035
Lime	4035	4070
Lime & shale	4070	4185
Lime & chert	4185	4226
Lime	4226	4318
Sand	4318	4323
Shale sand	4323	4346
Sand	4346	4370
Lime	4370	4410 TD

RECEIVED  
STATE CORPORATION COMMISSION  
JUL 19 1968  
CONSERVATION DIVISION  
Wichita, Kansas