


STATE OF KANSAS
STATE CORPORATION COMMISSION

Form CP-4

WELL PLUGGING RECORD

Give All Information Completely
Make Required Affidavit
Mail or Deliver Report to:
Conservation Division
State Corporation Commission
P. O. Box 17027
Wichita, Kansas 67217

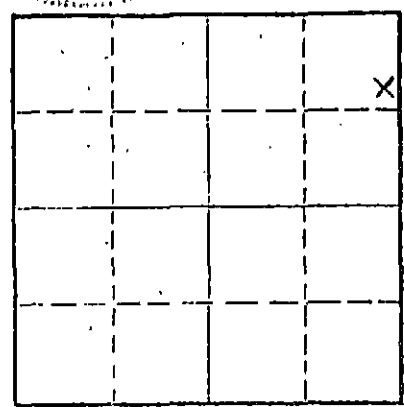

Locate well correctly on above Section Plat

Pratt County, Sec 33 Twp. 26 Rge. 13 (E) W (W)
Location as "NE/CNW&SW" or footage from lines SE NE NE
Lease Owner Dundee Pipe & Supply
Lease Name Calbeck Well No. # 13
Office Address P. O. Box 2391 ; Tulsa, Oklahoma
Character of Well (completed as Oil, Gas or Dry Hole) Oil
Date well completed March 5 19 52
Application for plugging filed July 19 73
Application for plugging approved July 19 73
Plugging commenced August 10 19 73
Plugging completed August 30 19 73
Reason for abandonment of well or producing formation Not commercial

If a producing well is abandoned, date of last production 19
Was permission obtained from the Conservation Division or its agents before plugging was commenced? Yes

Name of Conservation Agent who supervised plugging of this well Russell Biberstein
Producing formation Viola Depth to top Bottom Total Depth of Well 4437 Feet
Show depth and thickness of all water, oil and gas formations.

OIL, GAS OR WATER RECORDS

CASING RECORD

FORMATION	CONTENT	FROM	TO	SIZE	PUT IN	PULLED OUT
				8 5/8"	847	None
				5 1/2"	4433	3117

Describe in detail the manner in which the well was plugged, indicating where the mud fluid was placed and the method or methods used in introducing it into the hole. If cement or other plugs were used, state the character of same and depth placed, from feet to feet for each plug set.

August 10, 1973 Plugged off bottom. Dumped sand to 4000'. Mixed and dumped 5 sx of cement.
August 30, 1973 Plugged off top. Set 250' rock bridge at 250'. Filled 8 5/8" surface casing from 250' to base of cellar with 3000 lb. ready-mix concrete. (PSI)

RECEIVED
STATE CORPORATION COMMISSION

SEP 10 1973 9-10-73

CONSERVATION DIVISION
Wichita, Kansas

(If additional description is necessary, use BACK of this sheet)

Name of Plugging Contractor RUSS CASING PULLING, INC.
Address P. O. Box 1082 ; Great Bend, Kansas 67530

STATE OF Kansas, COUNTY OF Barton, ss.
Russell D. Sullivan (employee of owner) or (owner) of the above-described


well as filed and that the same are true and correct. So help me God.

(Signature) Russell Sullivan

P. O. Box 1082, Great Bend, Kansas 67530
(Address)

Subscribed and Sworn to before me this 7th day of September, 19 73

William D. Kuchel
Notary Public.

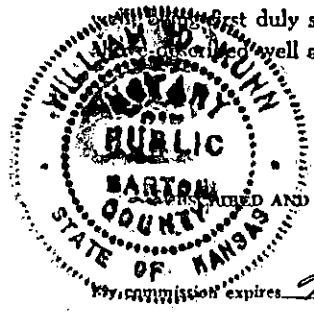

COPY

Cont'd

Company- Deep Rock

Farm - Calbeck No. 13

33-26-13W

SE NE NE

Good stain 4256-97'

Cored 4297-4301

rec. 14½'

This is description of core

Cored 4316-4331

rec. 16'

Fair to good sat. 4312-16'

Strks spotted sat. 4316-19'

Streaks good sat. 4319-21'

Spotted shows 4321-27'

Some strks spotted stain

4327-33'

Fair to good stain 4333-40'

Fair stain 4398-4411'

Trace stain, fair to good

show free oil 4415-24'

Fair show free oil 4427-37'

DST: 3339-58' open 1 hr.

good blow which decreased

to fair blow at end of test

rec. 420' gas & 100' slightly

oil & gas cut mud. BHP 480#

(15 min) Initial flow pressure

43# final flow pressure 90#

DST: 3798-3820 open 45 mins.

very strong blow throughout

test, rec. 75' oil & gas cut

mud 150' clean gassy oil.

BHP 960# (15 min.)

DST: 4300-31' open 1 hr; very

strong blow throughout test;

gas to surface in 15 mins,

rec. 180' heavily oil & gas

cut mud & 310' clean gassy

oil. BHP 1095# (15 min.)

Initial flow pressure 85#

Final flow pressure 195#.

DST: 4423-37' open 1 hr. strong

blow throughout test; gas to

surface in 59 mins. rec. 180'

muddy oil & 180' clean oil.

BHP 675# (15 mins.)

Note: All measurements are taken from the top of the rotary bushing which is 2 feet above the derrick floor.

RECEIVED
STATE CORPORATION COMMISSION
JUL 23 1973
CONSERVATION DIVISION
Wichita, Kansas