

Give All Information Completely
Make Required Affidavit
Mail or Deliver Report to:
Conservation Division
State Corporation Commission
212 No. Market
Wichita, Kansas

WELL PLUGGING RECORD

Pratt County, Sec. 33 Twp. 26S Rge. (E) 13 (W)

Location as "NE/CNW/SW" or footage from lines SW SW NE

Lease Owner West Supply Company

Lease Name Galbeck Well No. 1

Office Address Box 327, Chase, Kansas

Character of Well (completed as Oil, Gas or Dry Hole) oil

Date well completed October 29 19 48

Application for plugging filed June 3 19 66

Application for plugging approved June 6 19 66


Plugging commenced August 6 19 66

Plugging completed August 11 19 66

Reason for abandonment of well or producing formation depleted

If a producing well is abandoned, date of last production _____ 19 _____

Was permission obtained from the Conservation Division or its agents before plugging was commenced? yes

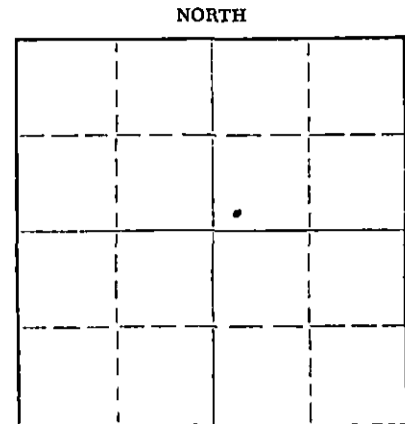

Locate well correctly on above Section Plat

Name of Conservation Agent who supervised plugging of this well Archie V. Elving

Producing formation _____ Depth to top _____ Bottom _____ Total Depth of Well 4441 Feet

Show depth and thickness of all water, oil and gas formations.

OIL, GAS OR WATER RECORDS

CASING RECORD

FORMATION	CONTENT	FROM	TO	SIZE	PUT IN	PULLED OUT
		0	821'	8 5/8"	821'	none
		0	4435'	5 1/2"	4435'	2938.05

Describe in detail the manner in which the well was plugged, indicating where the mud fluid was placed and the method or methods used in introducing it into the hole. If cement or other plugs were used, state the character of same and depth placed, from _____ feet to _____ feet for each plug set.

Pushed plug to 3700', set 10' rock bridge and dumped 5 sacks of cement at 3690'.

Pushed plug to 325', set 10' rock bridge and dumped 4 sacks of cement.

Bailed hole down and dumped 21 sacks of cement. Filled hole with dirt to 40', set 10' rock bridge and capped hole with 10 sacks of cement.

RECEIVED
STATE CORPORATION COMMISSION

AUG 17 1966

CONSERVATION DIVISION
Wichita, Kansas

(If additional description is necessary, use BACK of this sheet)

Name of Plugging Contractor Pipe Pullers, Inc.

Address Box 486, Ellinwood, Kansas

STATE OF Kansas, COUNTY OF Barton, ss. Dean Wells

(employee of owner) or (owner or operator) of the above-described well, being first duly sworn on oath, says: That I have knowledge of the facts, statements, and matters herein contained and the log of the above-described well as filed and that the same are true and correct. So help me God.

(Signature) Dean Wells

Ellinwood, Kansas
(Address)

SUBSCRIBED AND SWORN TO before me this 15th day of August, 19 66

[Signature]
Notary Public.

My commission expires July 7, 1968

WELL LOG BUREAU - KANSAS GEOLOGICAL SOCIETY
412. Union National Bk. Bldg., Wichita, Kansas

15-151-00115-0000


COPY

Company - DEEP ROCK et al
Farm - Calbeck No. 1

SEC. 33 T. 26 R. 13W
S7 S7 E2

Total Depth. 4440
Comm. 10-12-48 Comp. 10-29-48
Shot or Treated.
Contractor. A. J. Rine Drilling Co.
Issued. 1-15-49

County - Pratt KANSAS

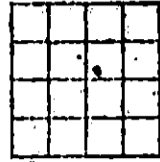

Elevation. _____

Production. Pot 50 bbl

CASING:

8 5/8" 821' cem
5 1/2" 4435' cem

Figures Indicate Bottom of Formations.

shale, sand	496
red rock, shale	1480
sand, shale	1815
shale, shells	2005
shale, lime	2170
shale	2300
lime, shale	2605
shale, shells	2710
lime, shale	2855
shale	3025
shale, shells	3265
shale, lime	3655
shale	3775
lime, shale	3815
lime	3930
lime, shale	3955
lime	4060
lime, shale	4205
shale, chert	4254
lime	4279
shale	4310
shale, chert	4325
shale	4342
sand	4358
sand, shale	4394
shale	4427
lime	4440
Total Depth	

Formations:

Kansas City Lime	3775
Mississippi	4196
Viola	4238
Simpson shale	4325
Guyton sand	4342
Arbuckle	4432

RECEIVED
STATE CORPORATION COMMISSION

AUG 17 1966

CONSERVATION DIVISION
Wichita, Kansas