

STATE OF KANSAS
STATE CORPORATION COMMISSION

WELL PLUGGING RECORD

Give All Information Completely
Make Required Affidavit
Mail or Deliver Report to:
Conservation Division
State Corporation Commission
211 No. Broadway
Wichita, Kansas

Pratt

County. Sec. 34 Twp. 26S Rge. 13(W)

Location as "NE/CNW/SW" or footage from lines NW/4 NW/4 NW/4

Lease Owner Lion Oil Company

Lease Name Drews Well No. 2

Office Address P. O. Box 580, Pratt, Kansas

Character of Well (completed as Oil, Gas or Dry Hole) Oil

Date well completed 2-21 19 61

Application for plugging filed 10-3 19 61

Application for plugging approved 10-6 19 61

Plugging commenced 10-28 19 61


Plugging completed 11-3 19 61

Reason for abandonment of well or producing formation Well had reached its economic limit.

If a producing well is abandoned, date of last production 8-1 19 61

Was permission obtained from the Conservation Division or its agents before plugging was commenced? Yes

NORTH

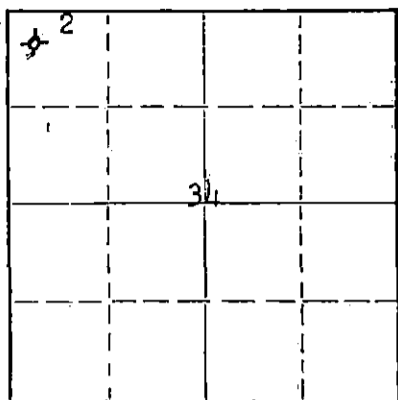

Locate well correctly on above Section Plat

Name of Conservation Agent who supervised plugging of this well

Producing formation Viola Depth to top 427 Bottom 4286 Total Depth of Well 443 Feet

Show depth and thickness of all water, oil and gas formations.

OIL, GAS OR WATER RECORDS

CASING RECORD

FORMATION	CONTENT	FROM	TO	SIZE	PUT IN	PULLED OUT
				8-5/8"	839'	None
				5-1/2"	4404'	3053'

Describe in detail the manner in which the well was plugged, indicating where the mud fluid was placed and the method or methods used in introducing it into the hole. If cement or other plugs were used, state the character of same and depth placed, from _____ feet to _____ feet for each plug set.

Sanded back to 4250' and dumped 5 sacks cement.
Mudded up to 300' and set 10' rock bridge.
Dumped 20 sacks cement. Mudded up to 40' and set 10' rock bridge. Capped the well with 10 sacks cement. Plugging completed.

11-9-61

RECEIVED
STATE CORPORATION COMMISSION

NOV 9 1961

CONSERVATION DIVISION
Wichita, Kansas

(If additional description is necessary, use BACK of this sheet)
Name of Plugging Contractor Forbes Casing Pulling, Inc.
Address Box 221, Great Bend, Kansas

STATE OF KANSAS, COUNTY OF PRATT, ss.
Bruce E. Roll (employee of owner) or (owner or operator) of the above-described

well, being first duly sworn on oath, says: That I have knowledge of the facts, statements, and matters herein contained and the log of the above-described well as filed and that the same are true and correct. So help me God.

(Signature) Bruce E. Roll
Box 580, Pratt, Kansas (Address)

SUBSCRIBED AND SWORN to before me this 8th day of November, 19 61

My commission expires September 4, 1962

Van Doubek Notary Public.



RECEIVED
STATE CORPORATION COMMISSION

OCT 4 1961

Drews Well No. 2

NW NW NW
Sec. 34-26S-13W
Pratt County
Kansas

CONSERVATION DIVISION
Wichita, Kansas

10-4-61

Contractor: The R. W. Rine Drilling Company
Started: 2/2/51 Finished: 2/15/51

LOG

Clay & Sand	0	50	
Sand & Shells	50	425	
Shells & Red Bed	425	820	Syfo @ 537 - 1/2°
Anhydrite	820	854	8-5/8" @ 847
Anhydrite, Shale, Shells	854	1100	Syfo @ 1000' - 1°
Shale & Shells	1100	1780	Syfo @ 1500 - 1/2°
Lime	1780	1975	
Lime & Shale	1975	3573	Syfo @ 2000' - 0°
Lime	3573	3695	Syfo @ 2500 - 1/2°
Lime & Shale	3695	3795	Syfo @ 3000' - 0°
Lime	3795	3932	Syfo @ 3500 - 0°
Cherty Lime & Shale	3932	3990	
Lime	3990	4115	
Lime & Shale	4115	4395	
Lime	4395	4405	5 1/2" @ 4404' w/ 200 Sz.

State of Kansas)
County of Sedgwick) ss.

I, E. H. Sloyer, do hereby certify that the above is a true and accurate log of the Drews Well No. 2, located in the NW NW NW of Section 34-26S-13W, Pratt County, Kansas

E. H. Sloyer
Secretary

Subscribed to and sworn before me this 20th day of February, 1951

Wm. A. McKenzie
Notary Public

My Commission Expires September 18, 1952