


STATE OF KANSAS
STATE CORPORATION COMMISSION
Give All Information Completely
Make Required Affidavit
Mail or Deliver Report to:
Conservation Division
State Corporation Commission
800 Biting Building
Wichita, Kansas

WELL PLUGGING RECORD
OR
FORMATION PLUGGING RECORD

Strike out upper line when reporting plugging of formations.

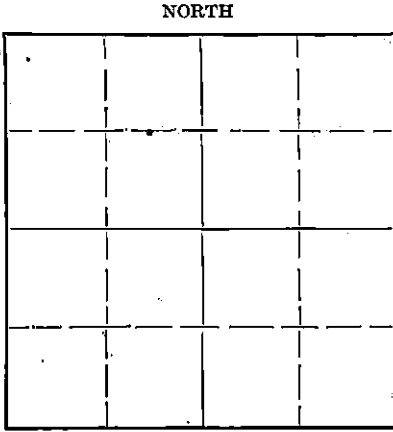

Locate well correctly on above Section Plat

Pratt County. Sec. 34 Twp. 26 Rge. 13 (E) W (W)
Location as "NE 1/4 NW 1/4 SW 1/4" or footage from lines C-E/2 NW/4 NW/4
Lease Owner Lion Oil Company
Lease Name Drews Well No. 3
Office Address Box 552, Pratt, Kansas
Character of Well (completed as Oil, Gas or Dry Hole) Dry Hole
Date well completed 3-19-51
Application for plugging filed 3-19-51
Application for plugging approved 3-19-51
Plugging commenced 3-19-51
Plugging completed 3-19-51
Reason for abandonment of well or producing formation Dry Hole

If a producing well is abandoned, date of last production 19...
Was permission obtained from the Conservation Division or its agents before plugging was commenced? Yes

Name of Conservation Agent who supervised plugging of this well Ruel E. Durkee
Producing formation Depth to top Bottom Total Depth of Well 4570 Feet
Show depth and thickness of all water, oil and gas formations.

OIL, GAS OR WATER RECORDS CASING RECORD

Formation	Content	From	To	Size	Put In	Pulled Out

Describe in detail the manner in which the well was plugged, indicating where the mud fluid was placed and the method or methods used in introducing it into the hole. If cement or other plugs were used, state the character of same and depth placed, from... feet to... feet for each plug set.

Heavy mud to 300' Set Bridging Plug w/ 15 Sacks Cement
Heavy mud to 30' Set Bridging Plug w./10 Sacks Cement

3-12-51
MAR 12 1951
CONSERVATION DIVISION
Wichita, Kansas

(If additional description is necessary, use BACK of this sheet)
Correspondence regarding this well should be addressed to Vernon Hayes,
Address Box 552, Pratt, Kansas

STATE OF Kansas, COUNTY OF Pratt, ss.
Vernon Hayes (employee of owner) or (owner or operator) of the above-described well,
being first duly sworn on oath, says: That I have knowledge of the facts, statements, and matters herein contained and the log of the above-described well as filed and that the same are true and correct. So help me God.

(Signature) Vernon Hayes
Box 552, Pratt, Kansas (Address)

SUBSCRIBED AND SWORN to before me this 10 day of March, 1951

My Commission Expires August 31, 1954
My commission expires... Notary Public.

PLUGGING
FILE SEC-34T-X6R130
PAGE-65-10-10

Drews Well No. 3

C E $\frac{1}{2}$ NW $\frac{1}{4}$ NW $\frac{1}{4}$
 Sec. 34-26S-13W
 Pratt County, Kansas

Contractor: The R. W. Rine Drilling Company
 Started: 2/16/51 Finished 3/2/51

LOG

Surface Clay	0 - 45	
Sand, Shale, Shells	45 - 750	Syfo @ 500' - O.K.
Red Bed Anhydrite	750 - 840	8-5/8" @ 825' w/450 Sx.
Shale, Shells	840 - 1850	Syfo @ 1000' - O.K.
Lime	1850 - 2315	Syfo @ 1500' - 1/2°
Shale	2315 - 2845	Syfo @ 2000' - O.K.
Shale - Broken Lime	2845 - 3370	Syfo @ 3000' - 1/2°
Lime	3370 - 3620	
Lime & Shale	3620 - 3710	
Lime	3710 - 4005	
Lime & Shale	4005 - 4067	
Lime	4067 - 4135	
Lime	4135 - 4250	
Lime	4250 - 4305	
Lime & Shale	4305 - 4350	
Cherty Lime	4350 - 4383	
Chert Shale	4383 - 4442	
Cherty Lime & Shale	4442 - 4490	
Lime & Shale	4490 - 4547	
Lime	4547 - 4570	T.D. D&A

State of Kansas)
 County of Sedgwick) ss.


I, E. H. Sloyer, do hereby certify that the above is a true and accurate log of the Drews Well No. 3, located in the C E $\frac{1}{2}$ NW $\frac{1}{4}$ NW $\frac{1}{4}$ of Section 34-26S-13W, Pratt County, Kansas.

E. H. Sloyer
 Secretary

Subscribed to and sworn before me this 8th day of March, 1951.

Vina A. McKenzie
 Notary Public

My Commission Expires September 18, 1952

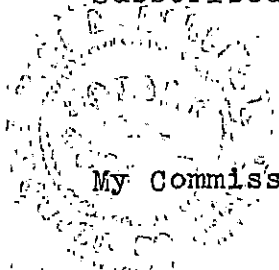

PLUGGING
 FILE SEC 34 T 76 R 13W
 BOOK PAGE 65 LINE 10

3-13-51
RECEIVED
 STATE CORPORATION COMMISSION
 MAR 13 1951
 CONSERVATION DIVISION
 Wichita, Kansas