


15-151-10859-80-80

STATE OF KANSAS
STATE CORPORATION COMMISSION

WELL PLUGGING RECORD

Give All Information Completely
Make, Require Affidavit
Mail or Deliver Report to:
Conservation Division
State Corporation Commission
800 Bitting Building
Wichita, Kansas

NORTH

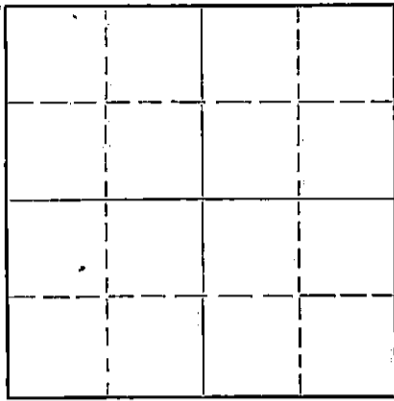

Locate well correctly on above
Section Plat

Pratt County. Sec. 34 Twp. 26S Rge. 13W (E) (W)
Location as "NE/CNW/SW" or footage from lines NW NW SW
Lease Owner Welch & Olsson Drilling Co., Inc.
Lease Name Drews Well No. 1
Office Address 1017 Union National Bank Bldg., Wichita, Kansas.
Character of Well (completed as Oil, Gas or Dry Hole) D & A
Date well completed 7-30 1953
Application for plugging filed 7-30 1953
Application for plugging approved 7-30 1953
Plugging commenced 7-30 1953
Plugging completed 7-30 1953
Reason for abandonment of well or producing formation D & A

If a producing well is abandoned, date of last production 19
Was permission obtained from the Conservation Division or its agents before plugging was commenced? Yes

Name of Conservation Agent who supervised plugging of this well M. A. Rives, Box 148, Pratt, Kansas.
Producing formation Depth to top Bottom Total Depth of Well 4380 Feet
Show depth and thickness of all water, oil and gas formations.

OIL, GAS OR WATER RECORDS

CASING RECORD

FORMATION	CONTENT	FROM	TO	SIZE	PUT IN	PULLED OUT
				8 5/8"	813	None

Describe in detail the manner in which the well was plugged, indicating where the mud fluid was placed and the method or methods used in introducing it into the hole. If cement or other plugs were used, state the character of same and depth placed, from feet to feet for each plug set.

Mudded to 300' and set wooden plug. Cemented and displaced 20 sacks cement through drill pipe onto plug. Mudded to 40' and set second plug, filled hole to bottom of well cellar with 10 sacks cement.

9-8-53

STATE OF KANSAS

COMMISSIONER

(If additional description is necessary, use BACK of this sheet)

Name of Plugging Contractor
Address

STATE OF Kansas, COUNTY OF Sedgwick, ss.
R. E. Welch

(owner or operator) of the above-described well, being first duly sworn on oath, says: That I have knowledge of the facts, statements, and matters herein contained and the log of the above-described well as filed and that the same are true and correct. So help me God.

(Signature) *R. E. Welch*


1017 Union National Bank Bldg. Wichita, Kans.
(Address)

SUBSCRIBED AND SWORN TO before me this 3rd day of August, 1953.

Marcella H. Waver
Notary Public.

My commission expires Feb. 27, 1956.

24-7369-S 3-53-20M

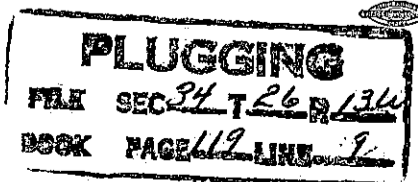

WELL LOG

WELCH & OLSSON DRILLING CO. INC.,

Elevation: 1950' R. B.

CONTRACTOR: Welch & Olsson Drilling Co. Inc.

Commenced Drlg.: 7-14-53

Draws No. 1

Completed Drlg: 7-30-53

NW NW SW Sec. 34-26S-13W,
Pratt County, Kansas.

Production: D & A

Casing Record:

Set 813' of 8 5/8" with 450 sacks.

(Figures indicate bottom of formations)

FORMATIONS

DEPTHS

FORMATION TOPS

Surface Soil	240
Shale with sand	260
Red Bed	400
Sand	500
Red Bed	775
Shale	890
Shale & Shells	1800
Lime & Shale	2580
Shale & Shells	3090
Lime & Shale	3320
Lime	3575
Shale & Chalky Lime	3634
Lime & Shale	3720
Lime & Sandy Shale	3810
Shale	3857
Lime	4120
Lime & Shale	4195
Cherty Lime	4309
Viola	4361
Simpson Sand	4380 T.D.

Heebner	3623'	-1673'
Brown Lime	3779'	-1829'
Lansing	3805'	-1858'
Base of the Kansas City Lime	4128'	-2178'
Mississippi	4231'	-2279'
Kinderhook	4253'	-2303'
Viola	4309'	-2359'
Simpson	4361'	-2411'

STATE OF KANSAS,

COUNTY OF SEDGWICK, SS:)

9-8-53

I hereby certify that the above is a true and correct copy of Drillers Log of Well drilled in the NW NW SW Sec. 34, Township 26S, Range 13 West, Pratt County, Kansas.

STATE LOG NO. 38321

AUG 28 1953

WELCH & OLSSON DRILLING COMPANY, INC.

CONSERVATION DIVISION
Wichita, Kansas

BY:

[Signature]

Subscribed and sworn to before me this 3rd day of August, 1953.

Marcello A. Davis

Notary Public

My Commission Expires: Feb. 27, 1956.

PLUGGING
FILE SEC 34 T 26 R 13W
BOOK PAGE 117 LINE 9