

STATE OF KANSAS
STATE CORPORATION COMMISSION


Give All Information Completely
Make Required Affidavit
Mail or Deliver Report to:
Conservation Division
State Corporation Commission
211 No. Broadway
Wichita, Kansas

14
WELL PLUGGING RECORD

Pratt County, Sec. 34 Twp. 26S Rge. 13W (14) (14)

Location as "NE/CNW/SW" or footage from lines NW SW NW
Lease Owner Lion Oil Company
Lease Name Drews Well No. 1
Office Address P. O. Box 580, Pratt, Kansas
Character of Well (completed as Oil, Gas or Dry Hole) Oil
Date well completed 1-28 19 51
Application for plugging filed Yes 10-3 19 61
Application for plugging approved Yes 10-6 19 61
Plugging commenced 10-19 19 61
Plugging completed 10-24 19 61
Reason for abandonment of well or producing formation: Well had reached its economic limit.
If a producing well is abandoned, date of last production 10-12 19 61
Was permission obtained from the Conservation Division or its agents before plugging was commenced? Yes

NORTH

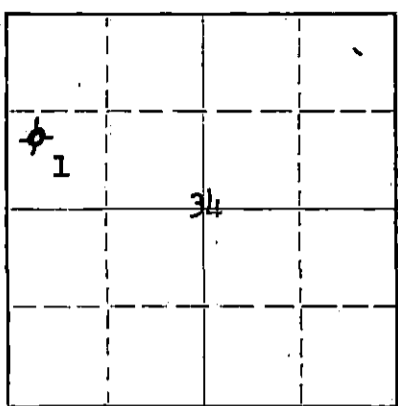

Locate well correctly on above Section Plat

Name of Conservation Agent who supervised plugging of this well W. L. Lackamp, Jr.
Producing formation Simpson Depth to top 4316 Bottom 4338 Total Depth of Well 4429 Feet
Show depth and thickness of all water, oil and gas formations. P.B.T.D. 4350'

OIL, GAS OR WATER RECORDS

CASING RECORD

| FORMATION | CONTENT | FROM | TO | SIZE | PUT IN | PULLED OUT |
|-----------|---------|------|----|--------|--------|------------|
| | | | | 8-5/8" | 827' | None |
| | | | | 5-1/2" | 4405' | 2,921' |
| | | | | | | |
| | | | | | | |
| | | | | | | |
| | | | | | | |

Describe in detail the manner in which the well was plugged, indicating where the mud fluid was placed and the method or methods used in introducing it into the hole. If cement or other plugs were used, state the character of same and depth placed, from _____ feet to _____ feet for each plug set.

Sanded back to 4300' and dumped 5 sacks cement.
Mudded well up to 300'. Set 10' rock bridge at 300'. Dumped 20 sacks of cement. Mudded up to 35' and set 10' rock bridge. Capped the well with 10 sacks cement.

10 30 - 61

RECEIVED
STATE CORPORATION COMMISSION

OCT 30 1961

CONSERVATION DIVISION
Wichita, Kansas

(If additional description is necessary, use BACK of this sheet)
Name of Plugging Contractor Forbes Casing Pulling, Inc.
Address P. O. Box 221, Great Bend, Kansas

STATE OF Kansas, COUNTY OF Pratt, ss.
Bruce E. Roll (employee of owner) or (owner or operator) of the above-described well, being first duly sworn on oath, says: That I have knowledge of the facts, statements, and matters herein contained and the log of the above-described well as filed and that the same are true and correct. So help me God.

(Signature) Bruce E. Roll
P. O. Box 580, Pratt, Kansas
(Address)

SUBSCRIBED AND SWORN to before me this 26th day of October, 19 61

My commission expires September 4, 1962

Van Doubek
Van Doubek Notary Public.

Drews Well No. 1

C NW SW NW
 Sec. 34-26S-13W
 Pratt County
 Kansas

RECEIVED
 STATE CORPORATION COMMISSION
 10-14-51
 OCT 4 1951

Contractor: The R. W. Rine Drilling Company
 Started: 1/14/51 Finished: 1/29/51

CONSERVATION DIVISION
 Wichita, Kansas

LOG

| | | | |
|---------------------|------|------|-----------------------------|
| Surface clay | 0 | 41 | |
| Sand shale | 41 | 340 | |
| Shale and sand | 340 | 825 | Syfo @ 500' - O.K. |
| Anhydrite | 825 | 840 | 8-5/8" @ 835' w/500' sk. |
| Shale and shells | 840 | 856 | Syfo @ 1000' - 0° |
| Shale and shells | 856 | 1795 | Syfo @ 1500' - O.K. |
| Lime | 1795 | 2200 | Syfo @ 2000' - 0° |
| Lime and shale | 2200 | 2395 | |
| Shale | 2395 | 3045 | Syfo @ 2500' - O.K. |
| Shale & broken lime | 3045 | 3200 | |
| Lime & shale | 3200 | 3735 | Syfo @ 3000' - O.K. |
| Lime | 3735 | 4075 | Syfo @ 3500' - O.K. |
| Shale streak | 4075 | 4080 | |
| Lime | 4080 | 4191 | Syfo @ 4000' - O.K. |
| Conglomerate | 4191 | 4207 | |
| Cherty lime ? | 4207 | 4240 | |
| Cherty lime | 4240 | 4295 | |
| Chert shale | 4295 | 4333 | |
| Lime chert - shale | 4333 | 4342 | |
| Lime | 4342 | 4346 | |
| Sand | 4346 | 4354 | |
| Shale | 4354 | 4366 | |
| Shale and lime | 4366 | 4413 | 5 1/2" csg. @ 4412 w/2009x. |

State of Kansas)
 County of Sedgwick) ss.

I, E. H. Sloyer, do hereby certify that the above is a true and accurate log of the Drews Well No. 1, located in the C NW SW NE of Section 34-26S-13W, Pratt County, Kansas.

E. H. Sloyer
 Secretary

Subscribed to and sworn before me this 2nd day of February, 1951.

Uma A. McKenzie
 Notary Public

My Commission Expires September 18, 1952