


STATE OF KANSAS  
STATE CORPORATION COMMISSION

WELL PLUGGING RECORD

Give All Information Completely  
Make Required Affidavit  
Mail or Deliver Report to:  
Conservation Division  
State Corporation Commission  
800 Biting Building  
Wichita, Kansas

Pratt County. Sec. 35 Twp. 26 Rge. 13 (E) W (W)  
Location as "NE/CNW $\frac{1}{4}$ /SW $\frac{1}{4}$ " or footage from lines SE SE SE  
Lease Owner Bennett & Roberts Oil Operations  
Lease Name Brown Well No. 1  
Office Address Russell, Ks.  
Character of Well (completed as Oil, Gas or Dry Hole) Dry hole  
Date well completed 9/16 19 53  
Application for plugging filed 9/8 19 53  
Application for plugging approved 9/9 19 53  
Plugging commenced 9/11 19 53  
Plugging completed 9/16 19 53  
Reason for abandonment of well or producing formation Dry hole  
If a producing well is abandoned, date of last production 19  
Was permission obtained from the Conservation Division or its agents before plugging was commenced? Yes

NORTH

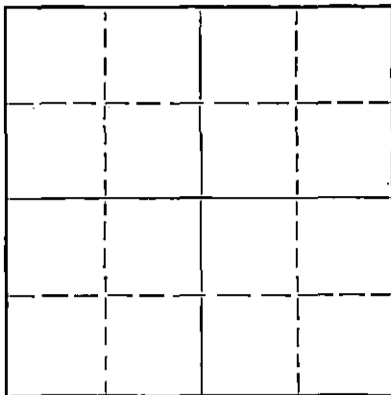

Locate well correctly on above  
Section Plat

Name of Conservation Agent who supervised plugging of this well M. A. Rives  
Producing formation Depth to top Bottom Total Depth of Well 4325 Feet  
Show depth and thickness of all water, oil and gas formations.

OIL, GAS OR WATER RECORDS

CASING RECORD

Formation	Content	From	To	Size	Put In	Pulled Out
				8. 5/8"	583'	None
				5. 1/2"	4324'	3014'

Describe in detail the manner in which the well was plugged, indicating where the mud fluid was placed and the method or methods used in introducing it into the hole. If cement or other plugs were used, state the character of same and depth placed, from feet to feet for each plug set.

Plugged back with crushed rock to 4220', dumped 5 sax cement at 4220' with dump bailer. Top of cement 4185'. Mixed 25 sax of mud and 100 sax cement by Sun Cem. Co. to plug surface pipe.

RECEIVED  
STATE CORPORATION COMMISSION  
SEP 23 1953  
CONSERVATION DIVISION  
Wichita, Kansas

(If additional description is necessary, use BACK of this sheet)  
Name of Plugging Contractor Miller Casing Pulling Co.  
Address Great Bend, Ks.

STATE OF KANSAS, COUNTY OF RUSSELL, ss.  
C. L. Roberts (employee of owner) or (owner or operator) of the above-described well,  
being first duly sworn on oath, says: That I have knowledge of the facts, statements, and matters herein contained and the log of the above-described well as filed and that the same are true and correct. So help me God.

(Signature) [Signature]  
Russell, Ks.  
(Address)

SUBSCRIBED AND SWORN to before me this 21st day of September, 19 53  
[Signature]  
Notary Public.

My commission expires 6/17/54

PLUGGING  
FILE SEC 35 T26 R13W  
BOOK PAGE 127 LINE 31

Bennett & Roberts Drilling Co.  
Brown #1

SE SE SE  
35-26-13  
Pratt County, Kansas

Comm: 7/11/53  
Comp: 7/30/53  
R.T.D. 4325'

Casing  
8 5/8" Set at 583'  
5 1/2" Set at 4324'

Cement  
350 sx.  
125 sx.

Formation:	Depth:
Surface Clay	75'
Sand	200
Red Bed, Shells	330
Sand	500
Shale & Shells	530
Red Bed	750
Shale & Shells	890
Anhydrite	940
Red Shale	1070
Shale & Shells	1590
Salt	1605
Shale & Shells	1900
Shale & Lime	2310
Salt	2340
Lime & Shale	3285
Lime	4078
Shale	4093
Lime & Shale	4122
Lime	4260
Shale	4325

9-9-53

STATE OF KANSAS )  
COUNTY OF RUSSELL) SS.

RECEIVED  
COMMISSION  
CONSERVATION DIVISION  
Wichita, Kansas

I hereby certify that the above information is true and correct to the best of my knowledge.

Law Law

Subscribed and sworn to before me this 31st day of July, 1953.

Chris Linn  
Notary Public

My Commission Expires 6/17/54

**PLUGGING**  
FILE SEC 25 T 26 R 13 W  
BOOK PAGE 127 LINE 31