

STATE OF KANSAS
STATE CORPORATION COMMISSION

WELL PLUGGING RECORD

OR
FORMATION PLUGGING RECORD


Strike out upper line when reporting plugging off formations.

Give All Information Completely
Make Required Affidavit
Mail or Deliver Report to:
Conservation Division
State Corporation Commission
800 Bittling Building
Wichita, Kansas

Pratt County, Sec. 35 Twp. 26 Rge. (E) 13..(W)

Location as "NE1/4NW1/4SW1/4" or footage from lines SW SW SE1/4
Lease Owner Shell Oil Co., Inc.
Lease Name J. T. Brown Well No. 1
Office Address Box 744, Great Bend, Kansas
Character of Well (completed as Oil, Gas or Dry Hole) Dry Hole
Date well completed 1-4 19 44
Application for plugging filed 1-11 19 44
Application for plugging approved 1-8 19 44
Plugging commenced 1-5 19 44
Plugging completed 1-5 19 44
Reason for abandonment of well or producing formation

NORTH

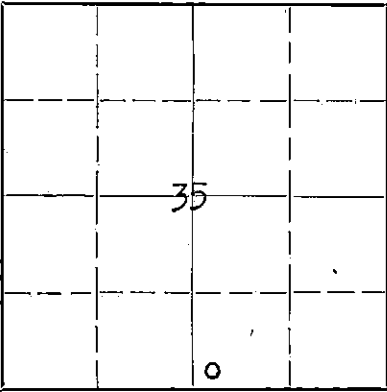

Locate well correctly on above Section Plat

If a producing well is abandoned, date of last production 19
Was permission obtained from the Conservation Division or its agents before plugging was commenced? Yes

Name of Conservation Agent who supervised plugging of this well G. T. Alexander
Producing formation Arbuckle Depth to top 4406 Bottom Total Depth of Well 4463 Feet
Show depth and thickness of all water, oil and gas formations.

OIL, GAS OR WATER RECORDS

CASING RECORD

Formation	Content	From	To	Size	Put In	Pulled Out
Arbuckle	540' muddy saltwater & 2675' saltwater - 15 min. DST.	4408	4463	8 5/8"	801	None

Describe in detail the manner in which the well was plugged, indicating where the mud fluid was placed and the method or methods used in introducing it into the hold. If cement or other plugs were used, state the character of same and depth placed, from feet to feet for each plug set.

Mudded hole from 4463' to 300'. Cemented with 15 sacks from 300' to 280'. Mudded from 280' to 26' and capped into cellar with 10 sacks of cement.

PLUGGING
FILE sec 35-26-130
BOOK PAGE 104 LINE 13

1-13-44

(If additional description is necessary, use BACK of this sheet)

Correspondence regarding this well should be addressed to Shell Oil Co., Inc.
Address c/o W. M. Gholson, Box 744, Great Bend, Kansas

STATE OF KANSAS COUNTY OF BARTON ss.
W. M. GHOLSON (employee of owner) of the above-described well,
being first duly sworn on oath, says: That I have knowledge of the facts, statements, and matters herein contained and the log of the above-described well as filed and that the same are true and correct. So help me God.

(Signature) [Signature]
Box 744, Great Bend, Kansas
(Address)

SUBSCRIBED AND SWORN to before me this 12th day of January, 19 44

My commission expires January 24, 1945

Bury Postlethwaite
Notary Public.



Shell, J. T. Brown #1
SW SW SE 35-26S-13W
Pratt County, Kansas

Casing Record

8 5/8" cem. 801 with 400 sax.

- 0 - 40 surface soil
- 100 sand
- 255 sand & shells
- 415 red bed & sand
- 585 red bed
- 1015 red bed & shells
- 1360 shale & shells
- 1595 salt & shale
- 1625 shale & shells
- 1625=1595 SLC (board)
- 1795 shale & shells
- 1795=1785 SLC (board)
- 1930 shale & shells
- 2044 lime
- 2150 lime & shale
- 2210 lime
- 2283 lime broken
- 2415 lime & shale
- 2477 lime
- 2539 lime & shale
- 2610 shale
- 3046 shale & lime
- 3120 lime
- 3200 broken lime
- 3288 sandy lime
- Top Topeka 3235
- 3323 lime
- 3393 broken lime
- 3463 lime & shale
- 3495 lime
- 3560 lime & shale
- 3606 lime
- 3688 shale & lime
- 3849 lime
- 3905 lime & chert
- Top Lans. Kans. City 3788
- 3946 lime & chert streaks
- 4134 lime
- 4213 lime & chert
- 4238 chert
- 4254 lime & shale
- 4256 lime, shale & chert
- Top Viola 4256
- 4269 chert
- 4292 lime & chert
- 4297 lime & shale
- Top Simpson 4297
- 4307 shale
- 4312 sand
- 4321 dolomite & shale
- 4328 sand & shale
- 4334 sand
- 4354 shale, some dolomite & sand

- 4360 dolomite
- 4382 shale
- 4395 dolomite & streaks shale
- Top Brecciated Arbuckle 4395.
- 4406 dolomite, weathered
- Top Solid Arbuckle 4406
- 4409 dolomite
- 4411 dolomite & some chert
- 4420 dolomite & trace shale
- 4431 dolomite
- 4442 dolomite & trace chert
- 4463 dolomite T.D.

PLUGGING
 FILE NO. 35-26-13W
 BOOK 104 PAGE 15

1-13-44

