


WELL PLUGGING RECORD

STATE OF KANSAS
 STATE CORPORATION COMMISSION
 Give All Information Completely
 Make Required Affidavit
 Mail or Deliver Report to:
 Conservation Division
 State Corporation Commission
 800 Bitting Building
 Wichita, Kansas

Pratt County, Sec. 1 Twp. 26 Rge. 14 (E) 14(W)
 Location as "NE/CNW/SW" or footage from lines: Ctr. NE/4 NW/4 SW/4

Lease Owner Lion Oil Company
 Lease Name Webster Well No. 1
 Office Address P. O. Box 639, Pratt, Kansas

Character of Well (completed as Oil, Gas or Dry Hole) Dry Hole
 Date well completed 3-15 19 53
 Application for plugging filed 3-15 19 53
 Application for plugging approved 3-15 19 53
 Plugging commenced 3-15 19 53
 Plugging completed 3-15 19 53
 Reason for abandonment of well or producing formation Dry Hole

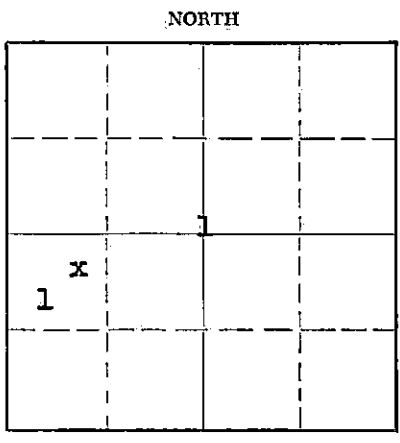

Locate well correctly on above Section Plat

If a producing well is abandoned, date of last production _____ 19____
 Was permission obtained from the Conservation Division or its agents before plugging was commenced? Yes

Name of Conservation Agent who supervised plugging of this well M. A. Rives
 Producing formation _____ Depth to top _____ Bottom _____ Total Depth of Well 4480 Feet
 Show depth and thickness of all water, oil and gas formations.

OIL, GAS OR WATER RECORDS

CASING RECORD

FORMATION	CONTENT	FROM	TO	SIZE	PUT IN	PULLED OUT
				8-5/8"	876'	0

Describe in detail the manner in which the well was plugged, indicating where the mud fluid was placed and the method or methods used in introducing it into the hole. If cement or other plugs were used, state the character of same and depth placed, from _____ feet to _____ feet for each plug set.

Plugged back with mud from 4480' to 300'.
 Plugged back with 1/3 sack hulls, 1 cement retainer plug, and 20 sacks of cement from 300' to 240'. Plugged back with mud from 240' to 35'. Plugged back with 1/3 sack hulls, 1 cement retainer plug, and 10 sacks of cement from 35' to base of cellar.

(If additional description is necessary, use BACK of this sheet)

Name of Plugging Contractor R. W. Rine Drilling Company
 Address 320 Central Building, Wichita, Kansas

STATE OF KANSAS COUNTY OF PRATT, ss.
Vernon Hayes (employee of owner) ~~is the owner or operator~~ of the above-described well, being first duly sworn on oath, says: That I have knowledge of the facts, statements, and matters herein contained and the log of the above-described well as filed and that the same are true and correct. So help me God.

(Signature) Vernon Hayes
P. O. Box 639, Pratt, Kansas
 (Address)

SUBSCRIBED AND SWORN TO before me this 25th day of March, 19 53
Dan Douber Notary Public.

My commission expires August 29, 1955

PLUGGING
 FILE SEC. 17-26R-431
 BOOK PAGE 25 LINE 5

24-2675-5 2-52-20M1
RECEIVED
 STATE CORPORATIC
 CONSERV
 WICHITA
 3-26-53

NE-NW-SW
 Sec. 1-26s-14w
 PRATT COUNTY, KANSAS

WEBSTER WELL No. 1

CONTRACTOR: THE R. W. RINE DRILLING COMPANY
 STARTED: 2-26-63 FINISHED: 3-15-53

LOG

SURFACE SAND	0	-	124	
CLAY & RED BED	124	-	885	SYFO @ 500' - 0'
ANHYDRITE	850	-	885	8 5/8' @ 876' w/240' sx
SHALE & SHELLS	885	-	1835	63' SX STRATOCRETE & 100' SX COMMON.
SHALE & LIME	1835	-	2180	SYFO @ 1000' - 10'
LIME	2180	-	2445	SYFO @ 2000' - 10'
LIME & SHALE	2445	-	3310	SYFO @ 3000' - 20'
LIME	3310	-	3425	
LIME & SHALE	3425	-	3620	SYFO @ 3500' - 40'
LIME	3620	-	3760	
LIME & SHALE	3760	-	3815	
LIME	3815	-	3888	
HARD LIME & SHALE	3888	-	3935	
LIME	3935	-	4058	SYFO @ 4000' - 10'
LIME - HARD & ROUGH	4058	-	4110	
LIME	4110	-	4163	
CHERTY LIME & SHALE	4163	-	4215	
LIME & CHERT	4215	-	4249	
SHALE & CHERT	4249	-	4285	
SAND & SHALE	4285	-	4310	
SAND, SHALE & CHERT	4310	-	4410	
LIME & SHALE	4410	-	4480	T.D. D & A - PLUGGED

I, R. M. GREEN, DO HEREBY CERTIFY THAT THE ABOVE IS A TRUE AND ACCURATE LOG OF THE WEBSTER WELL No. 1, LOCATED NE NW SW, SECTION 1-26s-14w, PRATT COUNTY, KANSAS.

R. M. Green
 ASSISTANT SECRETARY

SUBSCRIBED TO AND SWORN BEFORE ME THIS 24th DAY OF MARCH, 1953

Leonard Pederson
 NOTARY PUBLIC

MY COMMISSION EXPIRES APRIL 20, 1955.

PLUGGING
 WELL NO. 1-26-14W
 FROM 85' TO 410'

3-26-53