


STATE OF KANSAS  
STATE CORPORATION COMMISSION

WELL PLUGGING RECORD

Give All Information Completely  
Make Required Affidavit  
Mail or Deliver Report to:  
Conservation Division  
State Corporation Commission  
211 North Broadway  
Wichita, Kansas

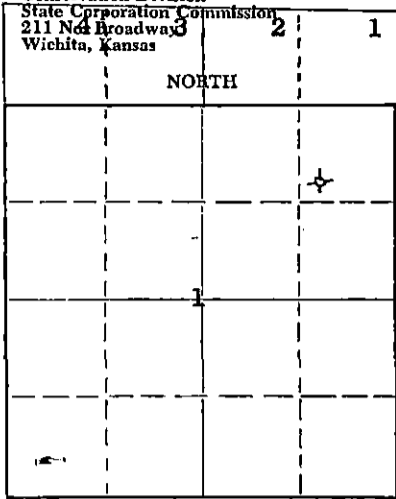

Locate well correctly on above  
Section Plat

Pratt County. Sec. 1 Twp. 26S Rge. (E) 14 (W)  
Location as "NE/CNW/SW" or footage from lines SWC of Lot 1  
Lease Owner The R. W. Rine Drilling Company, et al.  
Lease Name Morrison Well No. 1  
Office Address 420 Union Center, Wichita, Kansas  
Character of Well (completed as Oil, Gas or Dry Hole) Dry Hole  
Date well completed December 17, 19 57  
Application for plugging filed December 17, 19 57  
Application for plugging approved 19  
Plugging commenced December 17, 19 57  
Plugging completed December 17, 19 57  
Reason for abandonment of well or producing formation Non-productive

If a producing well is abandoned, date of last production None 19 19  
Was permission obtained from the Conservation Division or its agents before plugging was commenced? Yes

Name of Conservation Agent who supervised plugging of this well M. A. Rives  
Producing formation \_\_\_\_\_ Depth to top \_\_\_\_\_ Bottom \_\_\_\_\_ Total Depth of Well 4465 Feet  
Show depth and thickness of all water, oil and gas formations.

OIL, GAS OR WATER RECORDS				CASING RECORD		
FORMATION	CONTENT	FROM	TO	SIZE	PUT IN	PULLED OUT
Surface sands	water	0	180	8-5/8"	325'	

Describe in detail the manner in which the well was plugged, indicating where the mud fluid was placed and the method or methods used in introducing it into the hole. If cement or other plugs were used, state the character of same and depth placed, from \_\_\_\_\_ feet to \_\_\_\_\_ feet for each plug set.

Pumped very heavy mud into hole, filling to 300' below surface. Set wooden plug at 300'. Spotted 20 sacks on top of plug, using Halliburton equipment. Pumped heavy mud into hole, filling to 10'; set plug; spotted 15 sacks cement on top of plug, filling to 4 1/2' below ground level.

RECEIVED  
STATE CORPORATION COMMISSION  
12-24-57  
DEC 24 1957

CONSERVATION DIVISION  
Wichita, Kansas

(If additional description is necessary, use BACK of this sheet)  
Name of Plugging Contractor Halliburton Oil Well Cementing Company  
Address Pratt, Kansas

STATE OF KANSAS, COUNTY OF SEDGWICK, ss.  
PAUL A. HARPER (~~employee of owner~~) or (owner or operator) of the above-described well, being first duly sworn on oath, says: That I have knowledge of the facts, statements, and matters herein contained and the log of the above-described well as filed and that the same are true and correct. So help me God.

(Signature) Paul A. Harper  
The R. W. Rine Drilling Company  
420 Union Center, Wichita 2, Kansas  
(Address)

SUBSCRIBED AND SWORN TO before me this 18th day of December, 19 57

My commission expires July 9, 1960. Edna Landry Notary Public.

PLUGGING  
FILE SEC 1 T. 36R 146  
BOOK PAGE 71 LINE 8

The R. W. Rine Drilling Company  
420 Union Center  
Wichita, Kansas

Tulsa, Oklahoma  
December 23, 1957

CONTRACTOR: Stickle Drilling Company  
Drilling Commenced: December 3, 1957  
Drilling Completed: December 17, 1957

#1 Morrison Lot 1, Section  
1-26S-14W, Pratt County,  
Kansas.

DRILLERS LOG

Depth Figures Indicate base of formation:

Surface	0
Sand	250
Shale	326
Red Bed & Sand	570
Red Bed & Shale	870
Anhydrite	900
Shale & Shells	1800
Shale & Lime	1905
Lime & Shale	3405
Sandy Lime & Shale	3545
Lime & Shale	3750
Lime	3803
Lime & Shale	3845
Lime With Chert	3889
Lime	4038
Lime & Shale	4085
Lime	4210
Lime & Shale	4311
Lime With Chert	4332
Lime	4335
Lime With Chert	4362
Lime & Shale	4415
Lime & Sandy Shale	4455
Arbuckle	4466 TD

12-27-57  
RECEIVED  
STATE CORPORATION COMMISSION  
DEC. 27 1957  
CONSERVATION DIVISION  
Wichita, Kansas

I, Frank E. Stickle hereby certify the above to be a true and complete Drillers Log of The R. W. Rine Drilling Company's #1 Morrison Lot 1, Section 1-26S-14W, Pratt County, Kansas.

*Frank E. Stickle*  
Frank E. Stickle

*Lillian T. Bonham*  
Notary Public  
February 13, 1960  
My Commission Expires

PLUGGING	
FILE	SEC. 1-26 R14W
BOOK	PAGE 71 LINE 8