


WELL PLUGGING RECORD

Give All Information Completely
Make Required Affidavit
Mail or Deliver Report to:
Conservation Division
State Corporation Commission
800 Bitting Building
Wichita, Kansas

Pratt County, Sec. 1 Twp. 26 Rge. 14 (X) (W)

Location as "NE/CNWSW" or footage from lines NW NW SW
Lease Owner Petroleum, Inc.
Lease Name WEBSTER Well No. 1
Office Address 311 East Third, Wichita, Kansas
Character of Well (completed as Oil, Gas or Dry Hole) Dry Hole
Date well completed February 3, 19 55
Application for plugging filed February 3, 19 55
Application for plugging approved February 3, 19 55
Plugging commenced February 3, 19 55
Plugging completed February 3, 19 55
Reason for abandonment of well or producing formation Dry Hole

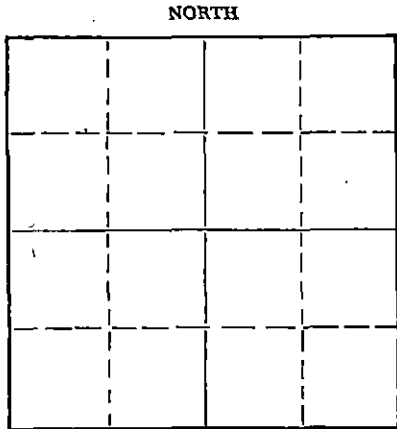

Locate well correctly on above Section Plat

If a producing well is abandoned, date of last production 19
Was permission obtained from the Conservation Division or its agents before plugging was commenced? Yes

Name of Conservation Agent who supervised plugging of this well Mr. M. A. Rives
Producing formation _____ Depth to top _____ Bottom _____ Total Depth of Well 445 Feet
Show depth and thickness of all water, oil and gas formations.

OIL, GAS OR WATER RECORDS

CASING RECORD

FORMATION	CONTENT	FROM	TO	SIZE	PUT IN	PULLED OUT
				8-5/8"	260'	None

Describe in detail the manner in which the well was plugged, indicating where the mud fluid was placed and the method or methods used in introducing it into the hole. If cement or other plugs were used, state the character of same and depth placed, from _____ feet to _____ feet for each plug set.

Mudded up to 250' and set first wooden plug at 250'. Placed 1 1/2 gal. hulls on top of plug. Displaced 20 sacks cement through drill pipe on top of hulls. Mudded up to 35' and placed second wooden plug. Placed 1/2 sack of hulls on top of plug. Displaced 10 sacks cement on top of hulls to cellar of well.

(If additional description is necessary, use BACK of this sheet)

Name of Plugging Contractor Garvey Drilling Company
Address R. R. #2 - Great Bend, Kansas

STATE OF KANSAS, COUNTY OF SEDGWICK, ss.
Karl E. Becker (employee of owner) of the above-described well, being first duly sworn on oath, says: That I have knowledge of the facts, statements, and matters herein contained and the log of the above-described well as filed and that the same are true and correct. So help me God.

(Signature) Karl E. Becker
311 East Third, Wichita, Kansas
(Address)

SUBSCRIBED AND SWORN TO before me this 11th day of February, 1955

My commission expires 8-11-58

Notary Public.

RECEIVED
FEB 24 1955
PLUGGING
CONSERVATION DIVISION
Wichita, Kansas
PAGE 92 LINE 24

2-24-55

WELL LOG

COMPANY **Petroleum, Inc.**

SEC. **1** T. **26S** R. **14W**

FARM **WEBSTER**

NO. **1**

LOC. **NW NW SW**


TOTAL DEPTH **4445'**

COUNTY **Pratt County, Kansas**

COMM. **January 20, 1955.**

COMP. **February 3, 1955.**

CONTRACTOR **Garvey Drilling Company**

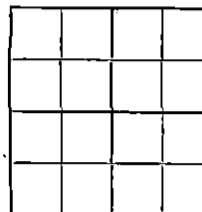

CASING **8-5/8" @ 260' w/225 sax.**

ELEVATION **1982' RB**

PRODUCTION **D & A**

FIGURES INDICATE BOTTOM OF FORMATIONS

245	Sand
260	Red Bed
450	Red Bed & Shale
1170	Shale, Sand & Red Bed
1755	Shale & Shells
2185	Lime & Shale
2570	Shale & Shells
3420	Lime & Shale
3735	Lime
3754	Shale
4214	Lime
4252	Lime & Chert
4267	Lime
4301	Shale
4325	Chert
4350	Lime & Chert
4383	Lime
4387	Sand
4445	Lime
4445	T.D.

Tops:

Heebner: 3598 (-1616)
 Brown Im: 3754 (-1772)
 Lansing: 3783 (-1801)
 Mississippi: 4240 (-2258)
 Viola: 4299 (-2317)
 Arbuckle: 4415 (-2434)

State of KANSAS

County of SEDGWICK

SS:

2-24-55

I, Karl E. Becker of Petroleum, Inc.

upon oath state that the above and foregoing is a true and correct copy of the log of the WEBSTER #1 well.

STATE COMMISSION

FEB 24 1955

Karl E. Becker

Subscribed and sworn to before me this 23rd day of February, 1955

My Commission Expires: 8-11-58

PLUGGING
 FILE REC 1726 D. 44
 BOX PAGE 95 LINE 24

Edwards
NOTARY PUBLIC