


STATE OF KANSAS
STATE CORPORATION COMMISSION

WELL PLUGGING RECORD

Give All Information Completely
Make Required Affidavit
Mail or Deliver Report to:
Conservation Division
State Corporation Commission
800 Bitting Building
Wichita, Kansas

Pratt County, Sec. 1 Twp. 26S Rge. 14 ~~W~~ W (W)
Location as "NE/CNW $\frac{1}{4}$ SW $\frac{1}{4}$ " or footage from lines 2310' N of S. Line & 330' E of W
Lease Owner DEEP ROCK OIL CORPORATION
Lease Name McCandless Well No. 1
Office Address Box 1051, Tulsa, Oklahoma
Character of Well (completed as Oil, Gas or Dry Hole) Dry Hole
Date well completed October 31 19 50
Application for plugging filed November 1 19 50
Application for plugging approved November 6 19 50
Plugging commenced November 2 19 50
Plugging completed November 2 19 50
Reason for abandonment of well or producing formation Dry Hole

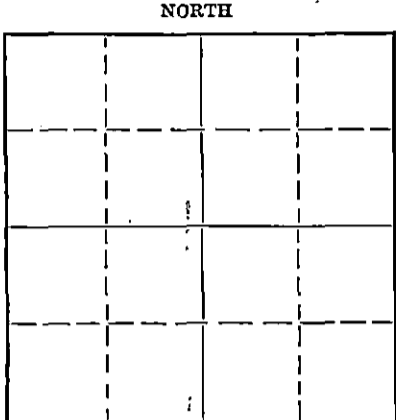

Locate well correctly on above
Section Plat

If a producing well is abandoned, date of last production 19
Was permission obtained from the Conservation Division or its agents before plugging was com-
menced? Yes

Name of Conservation Agent who supervised plugging of this well C.D. Stough
Producing formation Arbuckle Depth to top 4428' Bottom 4478' Total Depth of Well 4478' Feet
Show depth and thickness of all water, oil and gas formations.

OIL, GAS OR WATER RECORDS

CASING RECORD

Formation	Content	From	To	Size	Put In	Pulled Out
	Cemented from top to bottom			10 3/4"	801'	None

Describe in detail the manner in which the well was plugged, indicating where the mud fluid was placed and the method or methods used in introducing it into the hole. If cement or other plugs were used, state the character of same and depth placed, from _____ feet to _____ feet for each plug set.

Spotted through drill pipe 60 sacks cement by Halliburton
Cementing Company on bottom. Filled hole with heavy
rotary mud to 330'. Set bridge and spotted 20 sacks
cement to 30'. Set bridge and spotted 10 sacks cement
to top of hole and in cellar.

(If additional description is necessary, use BACK of this sheet)

Correspondence regarding this well should be addressed to Deep Rock Oil Corporation
Address Box 429, Hutchinson, Kansas

STATE OF Kansas, COUNTY OF Reno, ss.

Jack Smith (employee of owner) or (owner/lessee) of the above-described well,
being first duly sworn on oath, says: That I have knowledge of the facts, statements, and matters herein contained and the log of the above-
described well as filed and that the same are true and correct. So help me God.

(Signature) Jack Smith

Box 429, Hutchinson, Kansas
(Address)

SUBSCRIBED AND SWORN to before me this 14 day of November, 1950

My commission expires November 26-1951

23-5091-s 8-60-10M

RECEIVED
STATE CORPORATION COMMISSION
Notary Public. *Lozan*

NOV 15 1950

CONSERVATION DIVISION
Wichita, Kansas

PLUGGING
FILE SEC - T 26S R 14W
BOOK PAGE 40 LINE 39

11-15-50

Mail To J. A. Morgan

Kansas State Corp. Comm.
Conservation Division
800 Dittling Bldg.
Wichita, Kansas

Deep Rock Oil Corp. operator
McCandless Well No. 1

330' S 330' E. of N/4
Sec. 1-26S-14W
Pratt County
Kansas

15-151-10887-0000

Contractor: The R. W. Rine Drilling Company
Started 10/12/50

Finished: 11/2/50

LOG

Sand - Gravel	0	-	240	
Shale - Shells	240	-	370	
Red Bed - Shells	370	-	580	
Red Bed - Sand - Shells	580	-	805	10-3/4" Csg. @ 801 w/ 500 Sx.
Anhydrite	805	-	840	
Sand - Shale - Shells	840	-	1450	Syfo @ 1000' - 1 1/2°
Sand - Salt - Shells	1450	-	1600	Syfo @ 1500' - 1°
Shale - Shells	1600	-	1875	Syfo @ 1850' - 1 1/2°
Lime	1875	-	2185	Syfo @ 2000' - 1 1/2°
Lime - Shale	2185	-	2295	
Shale - Sand	2295	-	2435	
Shale	2435	-	2675	
Shale - Lime Streaks	2675	-	2810	
Shale - Lime	2810	-	3160	
Broken Lime	3160	-	3210	
Lime - Shale	3210	-	3550	Syfo @ 3500' - 2°
Lime	3550	-	3725	Syfo @ 3720' - 2°
Lime - Shale	3725	-	3780	
Lime	3780	-	3892	Syfo @ 3820 - 2°
Lime - Chert	3892	-	3918	
Shale - Lime	3918	-	3940	Syfo @ 3930' - 1-3/4°
Lime	3940	-	4034	
Chert - Lime	4034	-	4070	Syfo @ 4050' - 3/4°
Lime - Shale	4070	-	4139	
Lime	4139	-	4215	
Chert	4215	-	4330	
Lime - Chert - Shale	4330	-	4353	
Core #1	4353	-	4365	
Core #2 (Sand)	4365	-	4375	
Sand	4375	-	4385	
Shale	4385	-	4410	
Shale - Sand	4410	-	4428	
Lime (Arbuckle)	4428	-	4479	TD D&A

Plugged: Halliburton Plug @ 300' w/ 20 Sx.,
Halliburton Plug @ 30' w/ 10 Sx.

Tops: Brown Lime	3755
Lansing	3789
Conglomerate	4199
Kinderhook	4228
Viola	4293
Simpson	4355
Arbuckle	4426
TD	4479

State of Kansas)
County of Sedgwick) ss.

I, E. H. Sloyer, do hereby certify that the above is a true and accurate log of the McCandless Well No. 1, located 330' S 330' E OF N/4, Section 1-26S-14W, Pratt County, Kansas.

E. H. Sloyer
Secretary

Subscribed to and sworn before me this 6th day of November, 1950.

RECEIVED
STATE CORPORATIONS COMMISSION
Notary Public

My commission expires Dec. 29, 1952

CONSERVATION DIVISION
Wichita, Kansas

11-16-50