


STATE OF KANSAS
STATE CORPORATION COMMISSION
CONSERVATION DIVISION
P. O. BOX 17027
WICHITA, KANSAS 67217

FORM CP-4

WELL PLUGGING RECORD

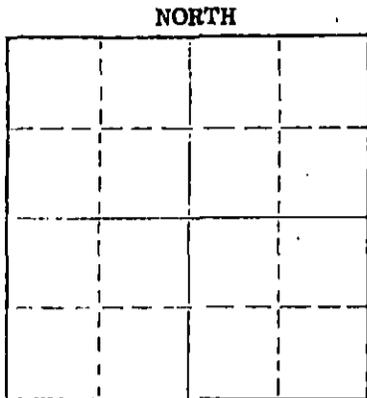

Locate well correctly on above Section Plat

Pratt County, Sec. 11 Twp. 26 Rge. 14 (E) (W)
Location as "NE/CNW&SW" or footage from lines NW NW SW
Lease Owner Raymond Oil Co., Inc.
Lease Name Moore C#2 Well No.
Office Address Wichita, Kansas 67202
Character of Well (completed as Oil, Gas or Dry Hole)
Date well completed 19
Application for plugging filed 19
Application for plugging approved 19
Plugging commenced 7/18/75 19
Plugging completed 7/18/75 19
Reason for abandonment of well or producing formation depleted

If a producing well is abandoned, date of last production 19
Was permission obtained from the Conservation Division or its agents before plugging was commenced? yes

Name of Conservation Agent who supervised plugging of this well Biberstein
Producing formation Depth to top Bottom Total Depth of Well 5208 Feet
Show depth and thickness of all water, oil and gas formations.

OIL, GAS OR WATER RECORDS

CASING RECORD

FORMATION	CONTENT	FROM	TO	SIZE	PUT IN	PULLED OUT
				8-5/8	917	none
				5 1/2	5200	none

Describe in detail the manner in which the well was plugged, indicating where the mud fluid was placed and the method or methods used in introducing it into the hole. If cement or other plugs were used, state the character of same and depth placed, from feet to feet for each plug set.

Ran sand and 5 sacks cement to 4500'. Set 20' rock bridge at 360' and filled hole with 6 yards ready mix.

PLUGGING COMPLETE.

RECEIVED
STATE CORPORATION COMMISSION
7-24-75
JUL 24 1975
CONSERVATION DIVISION
Wichita, Kansas

(If additional description is necessary, use BACK of this sheet)
Name of Plugging Contractor KNIGHT CASING PULLING CO., INC.
Address CHASE, KANSAS

STATE OF KANSAS COUNTY OF RICE
NOEL J. KNIGHT (employee of owner) or (owner or operator) of the above-described

well, being first duly sworn on oath, says: That I have knowledge of the facts, statements, and matters herein contained and the log of the above-described well as filed and that the same are true and correct. So help me God.

(Signature) Noel Knight
CHASE, KANSAS
(Address)

SUBSCRIBED AND SWORN TO before me this 22nd day of July, 1975


My commission expires

NOTARY PUBLIC
MARGARET MELCHER
Rice County, Ks.
My Comm. Exp. Feb. 15, 1979

Margaret Melcher
Notary Public.

15-151-10907-0001

KANSAS CORPORATION COMMISSION
 Conservation Division
 800 Building Building
 Wichita, Kansas

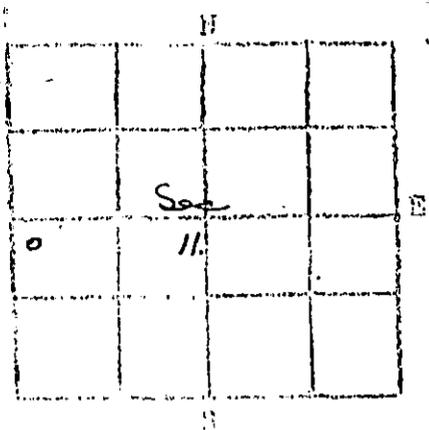

COUNTY Pratt SEC. 11 TWP. 26S RGE. 14W
 COMPANY OPERATING Chaplin Refining Company
 OFFICE ADDRESS Box 552 - Enid, Oklahoma
 FARM NAME Moore "C" WELL NO. 2
 WELL LOCATED NW/4 NW/4 SW/4 Section 11-26S-14W, or
2310' from south line and 330' from the west line of SW/4
 CHARACTER OF WELL Salt Water Disposal Well
 DRILLING COMMENCED November 30, 1953 DRILLING COMPLETED December 29, 1953

SIZE	DEPTH	SHES.	HAKE	FT.	AMOUNT PULLED	CEMENT
8-5/8"	203		917.48'	National		525 Sacks
5-1/2"	147		5256.80'	National		750 Sacks

FORMATION RECORD

	TOPS	BOTTOM		TOPS	BOTTOM
Sand	0	130	Limo-Chert	4946	5009
Sand-Red Bed	130	735	Sandy Limo-Chert	5009	5065
Red Bed	735	890	Sandy Limo	5065	5110
Anhydrite	890	920	Limo	5110	5187
Shale-Shells	920	1875	Limo-Sand	5187	5208 T.D.
Limo	1875	1970			
Shale-Limo	1970	2130			
Limo	2130	2215			
Shale-Limo	2215	2490			
Limo	2490	2610			
Shale-Limo	2610	3595			
Limo	3595	3695			
Shale-Limo	3695	3939			
Limo	3939	3961			
Shale-Limo	3961	4007			
Limo	4007	4050			
Shale-Limo	4050	4200			
Shale	4200	4210			
Shale-Conglomerate	4210	4238			
Shale-Limo	4238	4295			
Shale-Limo-Chert	4295	4323			
Limo-Chert	4323	4380			
Shale-Sand-Limo-Chert	4380	4405			
Shale-Limo	4405	4488			
Shale	4488	4490			
Limo, Arbuckle	4490	4532			
Limo	4532	4620			
Limo-Chert Streaks	4620	4659			
Limo	4659	4677			
Limo-Chert	4677	4727			
Limo-Chert Streaks	4727	4766			
Limo-Chert	4766	4912			
Limo-Chert-Sandy Limo	4912	4946			

GEOLOGICAL TOPS

Elevation - 1987' D.F.
 1990' K.B.

Cimarron Anhydrite	890
Reebner	3626
Brown Limo	3778
Lansing-Kansas City	3807
Conglomerate	4194
Viola Limo	4290
Simpson	4394
Arbuckle	4494
Hengen	5186
Granite	5200

RECEIVED
 STATE CORPORATION COMMISSION

JUL 15 1975
 7-15-75
 CONSERVATION DIVISION
 Wichita, Kansas

[Signature]
 Superintendent
 [Signature]
 Notary Public

30 January 4
 August 14, 1954