


STATE OF KANSAS
STATE CORPORATION COMMISSION

Form CP-4

WELL PLUGGING RECORD

Give All Information Completely
Make Required Affidavit
Mail or Deliver Report to:
Conservation Division
State Corporation Commission
211 No. Broadway
Wichita, Kansas

NORTH

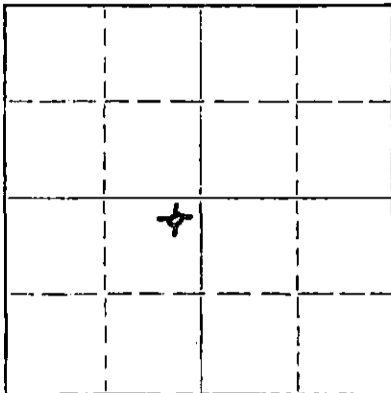

Locate well correctly on above
Section Plat

Pratt County. Sec. 11 Twp. 26S Rge. ~~14~~ 14(W)
Location as "NE/CNW/SW" or footage from lines NE - NE - SW
Lease Owner Champlin Petroleum Company
Lease Name Moore "C" Well No. 3
Office Address P. O. Box 308, Ellinwood, Kansas, 67526
Character of Well (completed as Oil, Gas or Dry Hole) Dry Hole
Date well completed February 28 19 66
Application for plugging filed February 28 19 66
Application for plugging approved (Verbal) February 27 19 66
Plugging commenced February 28 19 66
Plugging completed February 28 19 66
Reason for abandonment of well or producing formation

If a producing well is abandoned, date of last production 19
Was permission obtained from the Conservation Division or its agents before plugging was commenced? Yes

Name of Conservation Agent who supervised plugging of this well Archie V. Elving, Pratt, Kansas
Producing formation Depth to top Bottom Total Depth of Well 3970 Feet
Show depth and thickness of all water, oil and gas formations.

OIL, GAS OR WATER RECORDS

CASING RECORD

FORMATION	CONTENT	FROM	TO	SIZE	PUT IN	PULLED OUT
				8 5/8" OD	253'	None

Describe in detail the manner in which the well was plugged, indicating where the mud fluid was placed and the method or methods used in introducing it into the hole. If cement or other plugs were used, state the character of same and depth placed, from feet to feet for each plug set.

Filled hole with heavy mud from 3970' T.D. to 240'. Pushed plug and 1/2 sack of hulls to 240' and pumped in 25 sacks of cement thru drill pipe. Then filled hole with heavy mud to 40' and pushed plug and 1/2 sack of hulls to 40' and pumped in 10 sacks of cement filling hole to bottom of cellar. Pumped 2 sacks of cement in rat hole. (Used Halliburton to pump cement.)

3-9-66

RECEIVED
STATE CORPORATION COMMISSION

MAR 9 1966

(If additional description is necessary, use BACK of this sheet)

Name of Plugging Contractor Garvey Drilling Company
Address Route #2, Great Bend, Kansas

STATE OF KANSAS, COUNTY OF BARTON, ss.
J. W. Meyers (employee of owner) or ~~operator~~

well, being first duly sworn on oath, says: That I have knowledge of the facts, statements, and matters herein contained and the log of the above-described well as filed and that the same are true and correct. So help me God!

(Signature) J. W. Meyers
J. W. Meyers, Dist. Supt.
P. O. Box 308, Ellinwood, Kansas, 67526
(Address)

SUBSCRIBED AND SWORN TO before me this 8th day of March 19 66

My commission expires 5-22-66

N. Kenneth Stivers
Notary Public.

WELL LOG

COMPANY Champlin Petroleum Company

SEC. 2 T. 26S R. 14W

FARM Moore

NO. C-3

LOC. S.W. Moore Field

TOTAL DEPTH 3973'

COUNTY Pratt

COMM. 2-18-66

COMP. 2-28-66

CONTRACTOR Garvey Drilling Company

CASING 8 5/8" @ 252' w/225 sx

ELEVATION 1989' DF

PRODUCTION D & A

FIGURES INDICATE BOTTOM OF FORMATIONS

- 40' Sand and Clay
- 145' Sand and Shale
- 205' Sand and Gravel
- 253' Shale
- 875' Red Bed and Shale
- 910' Anhydrite
- 1635' Shale
- 1895' Lime and Shale
- 2060' Lime
- 2210' Lime and Shale
- 2530' Shale and Lime
- 3170' Lime and Shale
- 3460' Shale and Lime
- 3540' Lime and Shale
- 3710' Lime (Chalky)
- 3837' Lime and Shale
- 3973' Lime
- 3973' RTD

3-9-66

RECEIVED
 STATE OF KANSAS
 MAR 9 1966
 DEPARTMENT OF REVENUE

State of Kansas }
 County of Barton } SS

I, Sam N. Stephens of Garvey Drilling Company

upon oath state the above and foregoing is a true and correct copy of the log of the Moore No. C-3 well.

Sam N. Stephens

Subscribed and sworn to before me this 7th day of March 19 66

My Commission Expires: November 5, 1969

Richard D. Boy
 NOTARY PUBLIC