

STATE OF KANSAS
STATE CORPORATION COMMISSION

WELL PLUGGING RECORD

Give All Information Completely
Make Required Affidavit
Mail or Deliver Report to:
Conservation Division
State Corporation Commission
211 No. Broadway
Wichita, Kansas

Pratt County. Sec. 11 Twp 26 S Rge. 14 (KXX) (W)

Location as "NE/CNW/SW" or footage from lines SE NE NE

Lease Owner D.R. Lauck Oil Company, Inc.

Lease Name Webster Well No. 1

Office Address 301 So. Broadway Wichita 2 Kans

Character of Well (completed as Oil, Gas or Dry Hole) dry hole

Date well completed January 13 19 57

Application for plugging filed January 13 19 57

Application for plugging approved January 13 19 57


Plugging commenced January 13 19 57

Plugging completed January 13 19 57

Reason for abandonment of well or producing formation dry hole

If a producing well is abandoned, date of last production 19

Was permission obtained from the Conservation Division or its agents before plugging was commenced? yes

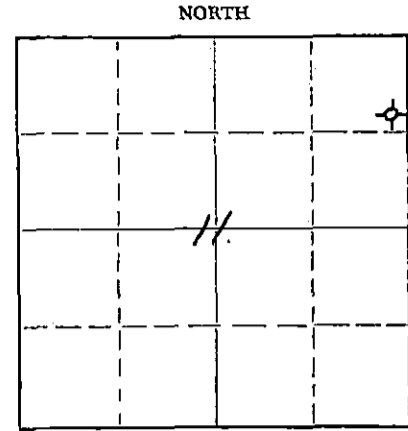

Locate well correctly on above Section Plat

Name of Conservation Agent who supervised plugging of this well M.A. Rives

Producing formation _____ Depth to top _____ Bottom _____ Total Depth of Well 4495 Feet

Show depth and thickness of all water, oil and gas formations.

OIL, GAS OR WATER RECORDS

CASING RECORD

FORMATION	CONTENT	FROM	TO	SIZE	PUT IN	PULLED OUT
		0	267	8 5/8"	267'	none

Describe in detail the manner in which the well was plugged, indicating where the mud fluid was placed and the method or methods used in introducing it into the hole. If cement or other plugs were used, state the character of same and depth placed, from _____ feet to _____ feet for each plug set.

filled hole with mud:

mud 4495 - 260'
plug 260 - 256
cement 256 - 216
mud 216 - 35
plug 35 - 31
cement 31 - 6' bottom of cellar

RECEIVED
STATE CORPORATION COMMISSION

JAN 15 1-19-57

CONSERVATION DIVISION
WICHITA, KANSAS

(If additional description is necessary, use BACK of this sheet)

Name of Plugging Contractor Globe Cementing Company

Address Great Bend Kansas

STATE OF Kansas COUNTY OF Sedgwick, ss.

John H. Knightley (employee of owner) or (owner or operator) of the above-described well, being first duly sworn on oath, says: That I have knowledge of the facts, statements, and matters herein contained and the log of the above-described well as filed and that the same are true and correct. So help me God.

(Signature) John H. Knightley

Wichita Kansas
(Address)

SUBSCRIBED AND SWORN TO before me this 18 day of January, 19 57

My commission expires Sept. 14, 1959

Elizabeth Gay
Notary Public.

PLUGGING
FILE SEC 11 T. 26 R. 14W
BOOK PAGE 134 LINE 22

D. R. Lauck Oil Company, Inc.

Webster #1

SE NE NE Sec.11-26S-14W
Pratt County, Kansas

Commenced: December 27 1956
Completed: January 13 1957

Elevation: GR 1978; DF 1981; KB 1983;

Casing Record: 267' 8 5/8" cem.w/225 sacks

Drillers Log

Tops

Clay & sand	210
red bed	380
red bed & sand	600
Red Bed	870
Anhydrite	885
shale & shells	1827
lime	2050
Lime & shale	3440
lime	3565
lime & shale	3776
lime	3995
lime & shale	4055
lime	4185
lime, shale & chert	4225
shale	4232
sand	4242
snad & shale	4247
shale & lime	4285
chert, Lime & shale	4310
chert & shale	4360
lime, chert & shale	4380
shale & sand	4420
shale	4480
Arbuckle	4495
rotary total depth	4495
D & A	

<u>Sample</u>	<u>Walliburton</u>
Anhydrite (Drillers)	870+1113
Heebner	3613-1630 3613-1630
Douglas	3654-1671 3655-1672
Brown Lime	3764-1781 3764-1781
Lansing	3792-1809 3796-1813
Base Kansas City	4096-2113 4097-2114
Mississippian	4210-2227 4213-2230
Kinderhook	4223-2240 4226-2243
Viola	4282-2299 4284-2301
Simpson	4382-2399 4385-2402
Arbuckle	4480-2497 4483-2500
Rotary Total Depth	4495-2512 4495-2512
DST #1 (M-D) 3932-3945 open 30 min-weak blow 15 min; recov.12' mud; BHP 50# in 20 min.	
DST #2 (M-D) 4233-4242 open 45 min, weak blow 25 min; recov.25' mud; BHP 60#,30 min.	
DST #3 (M-D) 4305-4330, open 30 min, weak blow 25 min, recov. 20' mud; BHP o# in 30 min.	
D & A.	

RECEIVED
STATE CORPORATION COMMISSION

JAN 19 1957 1-19-57

CONSERVATION DIVISION
Wichita, Kansas

PLUGGING
FILE SEC <u>11</u> T. <u>26</u> R. <u>14W</u>
BOOK PAGE <u>134</u> LINE <u>22</u>