

15-151-30182-00-01

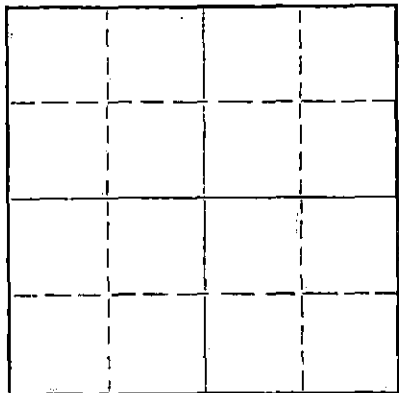
STATE OF KANSAS  
STATE CORPORATION COMMISSION

Form CP-4

Give All Information Completely  
Make Required Affidavit  
Mail or Deliver Report to:  
Conservation Division  
State Corporation Commission  
211 No. Broadway  
Wichita, Kansas

WELL PLUGGING RECORD

NORTH



Locate well correctly on above  
Section Plat

Pratt County, Sec. 3 Twp. 26 Rge. (E) 14 (W)  
Location as "NE/CNWxSWx" or footage from lines SE NW SE  
Lease Owner Time Petroleum Company  
Lease Name Moore Well No. 1  
Office Address 815 Union National Bldg., Wichita, Kansas  
Character of Well (completed as Oil, Gas or Dry Hole) Dry Hole  
Date well completed August 9 19 64  
Application for plugging filed August 9 19 64  
Application for plugging approved August 9 19 64  
Plugging commenced August 9 19 64  
Plugging completed August 9 19 64  
Reason for abandonment of well or producing formation Dry Hole

If a producing well is abandoned, date of last production 19  
Was permission obtained from the Conservation Division or its agents before plugging was commenced? Yes

Name of Conservation Agent who supervised plugging of this well Archie V. Elving, Pratt, Kansas  
Producing formation Depth to top Bottom Total Depth of Well 4318 Feet  
Show depth and thickness of all water, oil and gas formations.

OIL, GAS OR WATER RECORDS

CASING RECORD

FORMATION	CONTENT	FROM	TO	SIZE	PUT IN	PULLED OUT
	8-5/8"	0	290			

Describe in detail the manner in which the well was plugged, indicating where the mud fluid was placed and the method or methods used in introducing it into the hole. If cement or other plugs were used, state the character of same and depth placed, from feet to feet for each plug set.

Plugged hole as follows: Plugged at 275' with 25 sacks of cement and 1/4 sack of hulls and mud to 40', plugged with 10 sacks of cement and 1/4 sack of hulls. Job completed at 12:00 noon August 9th, 1964.

RECEIVED  
STATE CORPORATION COMMISSION  
AUG 13 1964  
8-13-64  
CONSERVATION DIVISION  
Wichita, Kansas

(If additional description is necessary, use BACK of this sheet)  
Name of Plugging Contractor Strata Drilling, Inc.  
Address P. O. Box 355, Great Bend, Kansas

STATE OF KANSAS, COUNTY OF BARTON, ss.  
Jim B. McWilliams (employee of owner) or (owner or operator) of the above-described well, being first duly sworn on oath, says: That I have knowledge of the facts, statements, and matters herein contained and the log of the above-described well as filed and that the same are true and correct. So help me God.

(Signature) Jim B. McWilliams, Secy-Treas.  
P. O. Box 355, Great Bend, Kansas  
(Address)

SUBSCRIBED AND SWORN TO before me this 12 th day of August, 19 64

My commission expires December 14, 1965

Elaine H. Taylor, Notary Public.

D R I L L E R S   L O G

#1 Moore

CASING RECORD:  
Washdown surface casing set in 1953.

COMPANY: Time Petroleum Company  
CONTRACTOR: Strata Drilling, Inc.

DESCRIPTION: SE NW SE  
Section 3-26S-14W  
Pratt County, Kansas

TOTAL DEPTH:  
4318'

COMMENCED: August 5, 1964  
COMPLETED: August 9, 1964

ELEVATION: 1990' RB

D. & A.

<u>FORMATION:</u>	<u>FROM</u>	<u>TO</u>	<u>REMARKS</u>
Lime	3920	4267	Washdown: This well was drilled to a depth of 3920' by Musgrove Petroleum in 1953.
Lime & Shale	4267	4160	
Lime & Chert Streaks	4160	4205	
Lime & Chert	4205	4250	
Lime	4250	4273	
Lime & Chert Streaks	4273	4318	

Total Depth 4318'

**RECEIVED**  
STATE CORPORATION COMMISSION

AUG 13 1964  
8-13-64

CONSERVATION DIVISION  
Wichita, Kansas

Ran one drill stem test.

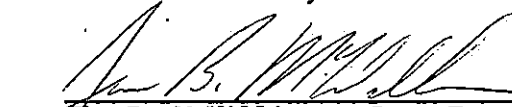
D. & A.

Plugged hole as follows: Plugged at 275' with 25 sacks of cement and  $\frac{1}{4}$  sack of hulls and mud to 40'; plugged with 10 sacks of cement and  $\frac{1}{4}$  sack of hulls. Job completed at 12:00 noon August 9, 1964.

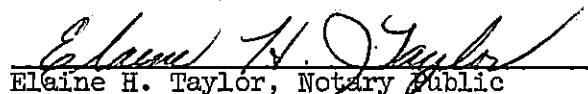
STATE OF KANSAS )  
                          ) ss.  
COUNTY OF BARTON)

I certify that this is a true and correct copy of the above log to the best of my knowledge.

STRATA DRILLING, INC.

  
Jim B. McWilliams, Secy-Treas.

Subscribed and sworn to before me this 12th day of August, 1964.

  
Elaine H. Taylor, Notary Public

My Commission Expires:

December 14, 1965