


STATE OF KANSAS  
STATE CORPORATION COMMISSION

WELL PLUGGING RECORD

Give All Information Completely  
Make Required Affidavit  
Mail or Deliver Report to:  
Conservation Division  
State Corporation Commission  
800 Bitting Building  
Wichita, Kansas

Pratt County. Sec. 3 Twp. 26 Rge. 14 (E) W (W)  
Location as "NE/CNW%SW%" or footage from lines SE NW SE  
Lease Owner Musgrove Petroleum Corporation  
Lease Name Moore Well No. #1  
Office Address 518 Petroleum Building  
Character of Well (completed as Oil, Gas or Dry Hole) Dry hole  
Date well completed August 6, 19 53  
Application for plugging filed August 5, 19 53  
Application for plugging approved August 7, 19 53  
Plugging commenced August 6, 19 53  
Plugging completed August 6, 19 53  
Reason for abandonment of well or producing formation

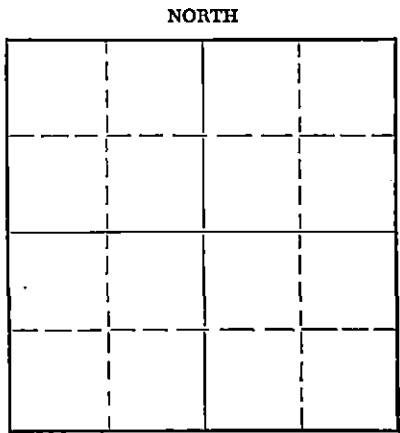

Locate well correctly on above Section Plat

If a producing well is abandoned, date of last production 19  
Was permission obtained from the Conservation Division or its agents before plugging was commenced?

Name of Conservation Agent who supervised plugging of this well  
Producing formation Depth to top Bottom Total Depth of Well 3920 Feet  
Show depth and thickness of all water, oil and gas formations.

OIL, GAS OR WATER RECORDS

CASING RECORD

FORMATION	CONTENT	FROM	TO	SIZE	PUT IN	PULLED OUT
				8-5/8	290'	

Describe in detail the manner in which the well was plugged, indicating where the mud fluid was placed and the method or methods used in introducing it into the hole. If cement or other plugs were used, state the character of same and depth placed, from feet to feet for each plug set.

Set bottom plug at 270' with 20 sacks cement.  
Set top plug at 40' with 10 sacks cement.

(If additional description is necessary, use BACK of this sheet)


Name of Plugging Contractor Musgrove Petroleum Corporation  
Address 518 Petroleum Building, Wichita, Kansas.

STATE OF Kansas, COUNTY OF Sedgwick  
I, Gordon L. Koelling (employee of owner) or (owner/operator) of the above-described well, being first duly sworn on oath, says: That I have knowledge of the facts, statements, and matters herein contained and the log of the above-described well as filed and that the same are true and correct. So help me God.

(Signature) *Gordon L. Koelling*  
518 Petroleum Building, Wichita, Kansas.  
(Address)

SUBSCRIBED AND SWORN to before me this 11th day of August, 19 53

My commission expires September 24, 1956  
Notary Public.

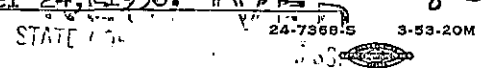

PLUGGING  
FILE SEC 3 T 26 R 14 W  
BOOK PAGE 120 LINE 17

CONTRACTOR'S WELL LOG

COMPANY: Musgrove Petroleum Corporation  
 CONTRACTOR: Musgrove Petroleum Corporation  
 FARM: MOORE #1  
 LOCATION: SE NW SE Sec. 3-26-14  
 Pratt County, Kansas.  
 COMMENCED: July 27, 1953  
 COMPLETED: August 6, 1953

0	230	Surface clay, sand
230	355	Red bed
355	891	Red bed & shale
891	907	Lime
907	1012	Blue shale
1012	1250	Red bed & shale
1250	1665	Shale & shells
1665	1855	Shale
1855	1982	Shale & shells
1982	3812	Lime & shale
3812	3920	Lime
	3920	Rotary Total Depth

Set 8-5/8" surface pipe at 290' with 290 sacks of cement.

Dry and Abandoned.

STATE OF KANSAS )  
 ) SS  
 COUNTY OF SEDGWICK )

I, GORDON L. KOELLING, do hereby certify that the above and fore-going is a true and correct copy of the log of the Moore #1, SE NW SE Section 3-26-14, Pratt County, Kansas, as reflected by the files of the Musgrove Petroleum Corporation.

MUSGROVE PETROLEUM CORPORATION

By *Gordon L. Koelling*  
 Secretary/Treasurer

Subscribed and sworn to before me, a Notary Public, in and for Sedgwick County, Kansas, this 11th day of August, 1953.

Notary-Public.

My commission expires September 24, 1956.

8-15-53

**PLUGGING**  
 FILE SEC 2 T26 R14u  
 BOOK PAGE 120 LINE 17

RECEIVED  
 DIVISION  
 Wichita, Kansas