


WELL PLUGGING RECORD

Give All Information Completely
Make Required Affidavit
Mail or Deliver Report to:
Conservation Division
State Corporation Commission
211 No. Broadway
Wichita, Kansas

NORTH

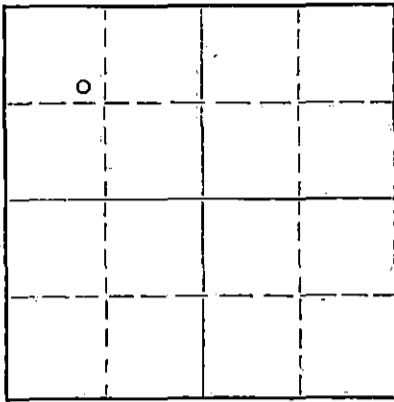

Locate well correctly on above
Section Plat

Reno County, Sec. 19 Twp. 23S Rge. (E) 7 (W)
Location as "NE/CNW/SW" or footage from lines. APP. SE NW NW
Lease Owner Messman-Rinehart Oil Company
Lease Name Ruxton Well No. 2
Office Address 518 Petroleum Building, Wichita, Kansas
Character of Well (completed as Oil, Gas or Dry Hole) Dry Hole
Date well completed September 18 1958
Application for plugging filed September 19 1958
Application for plugging approved September 22 1958
Plugging commenced October 6, 1958 1958
Plugging completed October 11 1958
Reason for abandonment of well or producing formation Dry

If a producing well is abandoned, date of last production 19
Was permission obtained from the Conservation Division or its agents before plugging was commenced? yes

Name of Conservation Agent who supervised plugging of this well Fred Hampel
Producing formation Depth to top Bottom Total Depth of Well 3705 Feet
Show depth and thickness of all water, oil and gas formations.

OIL, GAS OR WATER RECORDS

CASING RECORD

FORMATION	CONTENT	FROM	TO	SIZE	PUT IN	PULLED OUT
				8-5/8"	195'	none
				4-1/2"	3705'	3,111'

Describe in detail the manner in which the well was plugged, indicating where the mud fluid was placed and the method or methods used in introducing it into the hole. If cement or other plugs were used, state the character of same and depth placed, from feet to feet for each plug set.

Sand back to 3620 ft. and dumped 4 sx. cement, circulate 60 sx. jell mud, Set 10' rock bridge at 180' w/25 ex. cement, mud to 25', Set 10' rock bridge at 25' w/15 sx. cement, Mud to surface

RECEIVED
STATE CORPORATION COMMISSION

NOV 5 11-08-58
1958

CONSERVATION DIVISION
Wichita, Kansas

(If additional description is necessary, use BACK of this sheet)
Name of Plugging Contractor Southwest Casing Pulling Co., Inc. - License No. 399
Address P. O. Box 364, Great Bend, Kansas

STATE OF Kansas, COUNTY OF Sedgwick ss.
J. A. Gilliland (employee of owner) or (owner/operator) of the above-described well, being first duly sworn on oath, says: That I have knowledge of the facts, statements, and matters herein contained and the log of the above-described well as filed and that the same are true and correct. So help me God.

(Signature) *J. A. Gilliland*
518 Petroleum Building, Wichita, Kansas (Address)

SUBSCRIBED AND SWORN TO before me this 6th day of November 1958

My commission expires December 1, 1960

Barbara J. Scott, Notary Public.

PLUGGING
FILE SEC. 19 T23 R7W
BOOK PAGE 30 LINE 30

15155-00063-0000

NO. 2 RUXTON

Well Record:

Location: App. SE NW NW, Sec. 19-23S-7W
Reno County, Kansas

Commenced: August 22, 1958

Operator: Messman-Rinehart Oil Company
518 Petroleum Building
Wichita, Kansas

Completed: September 1, 1958
(rotary)

Elevation: 1615' K/B

Contractor: Messman-Rinehart Oil Company
518 Petroleum Building
Wichita, Kansas

Production:

Casing Record: 8-5/8" @ 195 ft. w/170 sx. cem., 3 gal, 3 c.c.
4-1/2" @ 3705' w/75 sx. cem.

*** LOG ***

Sand	65
Red Bed and Shale	195
Shale and Shells	655
Shale and Red Bed	1090
Anhydrite	1135
Lime and Shale	1810
Shale and Lime	2280
Lime and Shale	2915
Shale and Lime	3330
Lime and Shale	3210
Lime	3395
Lime and Shale	3515
Shale and Lime	3605
Shale	3640
Chert	3691
Lime	3705 R.T.D.

Sample Tops:

- 2890 (-1273) - Heebner
- 3082 (-1465) - Lansing
- 3636 (-2019) - Mississippi "Chat"
- 3692 (-2075) - Mississippi Lime

The undersigned, MESSMAN-RINEHART OIL COMPANY, hereby certifies that the above log is a true and correct log of the formation encountered in drilling the above well as reflected by the Daily Drilling Reports.

MESSMAN-RINEHART OIL COMPANY

By: J. A. Gilliland
J. A. Gilliland

Subscribed and sworn to before me
this 12th day of September, 1958.

Barbara J. Scott
Barbara J. Scott, Notary Public

My Commission Expires: December 1, 1960

RECEIVED
STATE CORPORATION COMMISSION
NOV 8 - 1958
CONSERVATION DIVISION
Wichita, Kansas

PLUGGING
FILE SEC. 19 T. 23 R. 7W
BOOK PAGE 130 LINE 38