


WELL PLUGGING RECORD

Give All Information Completely  
Make Required Affidavit  
Mail or Deliver Report to:  
Conservation Division  
State Corporation Commission  
800 Bittling Building  
Wichita, Kansas

Reno County, Sec. 33 Twp. 23S Rge. (E) 7 (W)  
Location as "NE/CNW $\frac{1}{4}$ SW $\frac{1}{4}$ " or footage from lines Center SE $\frac{1}{4}$  SE $\frac{1}{4}$  SW $\frac{1}{4}$   
Lease Owner The Atlantic Refining Company  
Lease Name Love Well No. 1  
Office Address P. O. Box 17, Great Bend, Kansas  
Character of Well (completed as Oil, Gas or Dry Hole) Dry hole  
Date well completed December 9 1950  
Application for plugging filed December 9 1950  
Application for plugging approved December 10 1950  
Plugging commenced December 10 1950  
Plugging completed December 10 1950  
Reason for abandonment of well or producing formation Dry hole

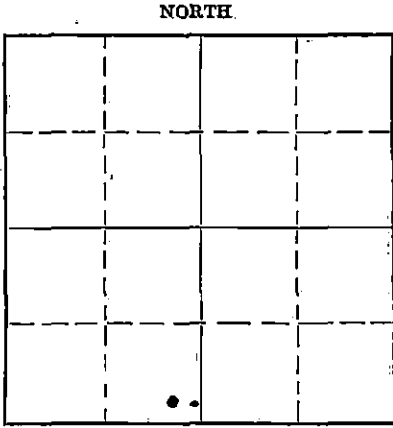

Locate well correctly on above Section Plat

If a producing well is abandoned, date of last production - 19  
Was permission obtained from the Conservation Division or its agents before plugging was commenced? Yes

Name of Conservation Agent who supervised plugging of this well Eldon Petty  
Producing formation Arbuckle Depth to top 4167 Bottom 4197 Total Depth of Well 4197 Feet  
Show depth and thickness of all water, oil and gas formations.

OIL, GAS OR WATER RECORDS

CASING RECORD

Formation	Content	From	To	Size	Put In	Pulled Out
		0	240	8 5/8	231	0

Describe in detail the manner in which the well was plugged, indicating where the mud fluid was placed and the method or methods used in introducing it into the hole. If cement or other plugs were used, state the character of same and depth placed, from \_\_\_\_\_ feet to \_\_\_\_\_ feet for each plug set.

Heavy mud 4197 to 230'  
Bridge Plug set at 230'  
20 sacks cement and heavy mud 230 to 210'  
5 sacks cement 210' to 20'  
20' to Bottom of cellar

RECEIVED  
STATE CORPORATION COMMISSION  
DEC 26 1950  
CONSERVATION DIVISION  
Wichita, Kansas 12-26-50

(If additional description is necessary, use BACK of this sheet)

Correspondence regarding this well should be addressed to The Atlantic Refining Co.  
Address Box 17, Great Bend, Kansas

STATE OF Kansas, COUNTY OF Barton, ss.  
Stanton K. Myers (employee of owner) or ~~OWNER OR AGENT~~ of the above-described well, being first duly sworn on oath, says: That I have knowledge of the facts, statements, and matters herein contained and the log of the above-described well as filed and that the same are true and correct. So help me God.

(Signature) Stanton K. Myers

Box 17, Great Bend, Kansas (Address)

SUBSCRIBED AND SWORN to before me this 22nd day of December, 19 50

Zita L. Bird

Notary Public.

My commission expires 7-29-51

PLUGGING  
FILE SEC-33T-23 R-27  
BOOK PAGE 48 LINE 13

15-155-00173-0000

THE ATLANTIC REFINING COMPANY  
830 Kennedy Building  
Tulsa, Oklahoma

KS-11,665  
Partridge Area

WELL LOG

LOVE NO. 1

Center SE SE SW of 33-23S-7W,  
Reno County, Kansas

SPUDED: 11-22-50  
REACHED T.D.: 12-9-50  
D&A - Plugged 12-10-50

CASING RECORD:  
231 ft. of 22# 8-5/8" casing set  
at 240 RKB w/225 sax cement and  
200# calcium chloride.

Formation Record

<u>FORMATION</u>	<u>TOP</u>	<u>BOTTOM</u>
Sandy shale	0	100
Red bed & shells	100	535
Shale & shells	535	700
Salt & shells	700	850
Shale & shells	850	1020
Lime & shale	1020	1210
Shale & lime	1210	1330
Lime & shale	1330	1505
Shale & lime	1505	1635
Lime & shale	1635	1825
Shale & shells	1825	2575
Lime & shale	2575	2650
Lime	2650	3020
Shale & hard sand	3020	3090
Sandy shale	3090	3116
Lime	3116	3675
Shale	3675	3708
Shale & chert	3708	3718
Chat & chert	3718	3800
Shale & chert	3800	3805
Shale	3805	4070
Sand	4070	4080
Sand & shale	4080	4085
Shale & sand	4085	4168
Lime	4168	4197

TOTAL DEPTH 4197

Dry and Abandoned.

RECEIVED  
CORPORATION COMMISSION  
DEC 26 1950  
CONSERVATION DIVISION  
Wichita, Kansas

PLUGGING  
FILE DEC 31 23 R 70  
BOOK PAGE 48 LINE 13