


15-095-00161-0000

STATE OF KANSAS
STATE CORPORATION COMMISSION

WELL PLUGGING RECORD

Give All Information Completely
Make Required Affidavit
Mail or Deliver Report to:
Conservation Division
State Corporation Commission
800 Bittling Building
Wichita, Kansas

Kingman County. Sec. 9 Twp. 27 Rge. 7 (E) (W)

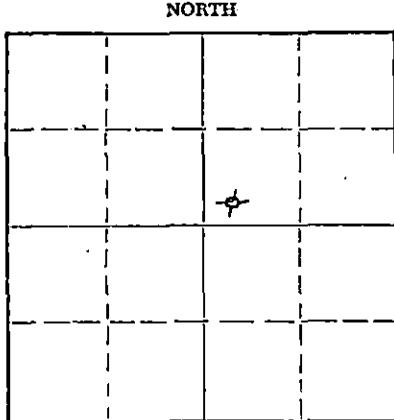

Location as "NE/CNWxSWx" or footage from lines SWCr NE/4
Lease Owner Virginia Drlg Co Inc et al
Lease Name Graber Well No. 1
Office Address 701 Brown Bldg. Wichita 2 Kansas
Character of Well (completed as Oil, Gas or Dry Hole) dry hole
Date well completed 3-12-56 19
Application for plugging filed 3-12-56 19
Application for plugging approved 3-12-56 19
Plugging commenced 3-12-56 19
Plugging completed 3-12-56 19
Reason for abandonment of well or producing formation

Locate well correctly on above
Section Plat

If a producing well is abandoned, date of last production 19
Was permission obtained from the Conservation Division or its agents before plugging was commenced? yes

Name of Conservation Agent who supervised plugging of this well Merle Rives
Producing formation Depth to top Bottom Total Depth of Well 3909 Feet
Show depth and thickness of all water, oil and gas formations.

OIL, GAS OR WATER RECORDS

CASING RECORD

FORMATION	CONTENT	FROM	TO	SIZE	PUT IN	PULLED OUT
		0	190	8 5/8"	199	none

Describe in detail the manner in which the well was plugged, indicating where the mud fluid was placed and the method or methods used in introducing it into the hole. If cement or other plugs were used, state the character of same and depth placed, from feet to feet for each plug set.

Mudded hole to 195 ft - set plug w/20 sx cement
Mudded hole to 35 ft - set plug w/10 sx cement & 1/4 sx hulls

3-14-56

CONC

(If additional description is necessary, use BACK of this sheet)
Name of Plugging Contractor Virginia Drilling Co Inc.
Address 701 Brown Bldg - Wichita 2, Kansas


STATE OF Kansas, COUNTY OF Sedgwick, ss.
S. A. Murphy (employee of owner) or (owner or operator) of the above-described well, being first duly sworn on oath, says: That I have knowledge of the facts, statements, and matters herein contained and the log of the above-described well as filed and that the same are true and correct. So help me God.

(Signature) S. A. Murphy
701 Brown Bldg - Wichita 2, Kansas
(Address)

SUBSCRIBED AND SWORN TO before me this 14th day of March 19 56

Murlee Hawkins
Notary Public.

My commission expires February 5, 1957

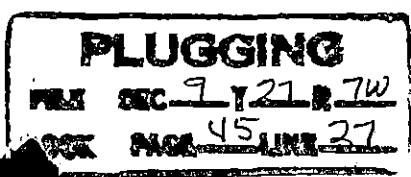

15-095-00161-0000

GRABER #1 - SW 1/4 NE/4 Section 9-27-7 Kingman County, Kansas
Company - Virginia Drilling Co. Inc. et al.
Contractor - same
Commenced - February 27, 1956
Completed - March 12, 1956
Elevation 1538 DF
Total Depth - 3909 8 5/8" set at 190 ft.

FORMATION	DEPTH
Sand-clay	0-90
Shale	90-150
Shale-shells	150-440
Blue Shale	440-660
Shale-salt-shells	660-810
Shale-shells	810-1325
Lime-shale	1325-1480
Broken lime	1480-1580
Lime-shale	1580-1695
Lime	1695-1727
Lime-shale	1727-1950
Shale-shells	1950-2265
Lime shale	2265-2840
Lime	2840-2995
Shale-lime-sand	2995-3125
Sand	3125-3130
Lime	3130-3250
Lime-shale	3250-3320
Lime	3320-3612
Lime shale	3612-3640
Lime	3640-3695
Lime-shale	3695-3857
Lime	3857-3909 TD

TOPS:
3170 - Kansas City
3857 - Mississippi

S. A. Murphy
S. A. Murphy

Subscribed and sworn to before me, a Notary Public, this
14th day of March, 1956.

Murlee Hawkins
Murlee Hawkins - Notary Public

My commission expires: February 5, 1957.

3-14-56

PLUGGING
WELL SEC 9 T 27 R 7W
BOOK PAGE 45 LINE 27