

15-095-10067-0000


STATE OF KANSAS
STATE CORPORATION COMMISSION

WELL PLUGGING RECORD

*Give All Information Completely
Make Required Affidavit
Mail or Deliver Report to:
Conservation Division
State Corporation Commission
800 Bittling Building
Wichita, Kansas

Kingman County, Sec. 9 Twp. 27S Rge. 7 (E) W (W)

Location as "NE/CNW/SW" or footage from lines SE/4 SW/4 SE/4
Lease Owner Heathman-Seeligson Drilling Co.
Lease Name Roxie Anderson Well No. 1
Office Address 1015 East Second, Wichita, Kansas
Character of Well (completed as Oil, Gas or Dry Hole) Dry Hole
Date well completed 4-11- 1955
Application for plugging filed 4-12- 1955
Application for plugging approved 4-12- 1955
Plugging commenced 4-11- 1955
Plugging completed 4-11- 1955
Reason for abandonment of well or producing formation Dry Hole

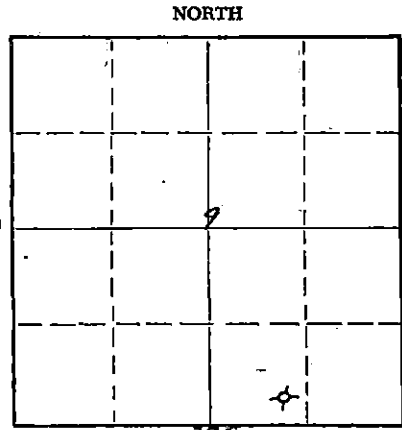

Locate well correctly on above
Section Plat

If a producing well is abandoned, date of last production -- 19
Was permission obtained from the Conservation Division or its agents before plugging was commenced? yes

Name of Conservation Agent who supervised plugging of this well Ruel Durkee, McPherson, Kansas
Producing formation -- Depth to top -- Bottom -- Total Depth of Well 4265 Feet
Show depth and thickness of all water, oil and gas formations.

OIL, GAS OR WATER RECORDS

CASING RECORD

FORMATION	CONTENT	FROM	TO	SIZE	PUT IN	PULLED OUT
--	--	--	--	6 jts. 8-5/8" new csg. set at 185.95' cemented w/125 sacks cement & 2 Calcium Chloride.		

Describe in detail the manner in which the well was plugged, indicating where the mud fluid was placed and the method or methods used in introducing it into the hole. If cement or other plugs were used, state the character of same and depth placed, from -- feet to -- feet for each plug set.

Stirred pits. Filled hole with heavy mud to 175'. Set wooden plug w/1/2 sacks hulls and 15 sacks cement. Filled hole with mud to 40' with 5 sacks of cement. Tied plug.

4-14-55

RECEIVED
STATE CORPORATION COMMISSION
APR 14 1955
CONSERVATION DIVISION
Wichita, Kansas

(If additional description is necessary, use BACK of this sheet)

Name of Plugging Contractor Heathman-Seeligson Drilling Co.
Address 1015 East Second, Wichita, Kansas

STATE OF Kansas, COUNTY OF Sedgwick, ss.
H. D. Shreve (employee of owner) or (owner) of the above-described well, being first duly sworn on oath, says: That I have knowledge of the facts, statements, and matters herein contained and the log of the above-described well as filed and that the same are true and correct. So help me God.

(Signature) By: [Signature]
1015 East Second, Wichita, Kansas
(Address)

SUBSCRIBED AND SWORN TO before me this 12 day of April, 1955

[Signature] Notary Public.

My commission expires June 28, 1955

PLUGGING
FILE SEC 9 T 27 R 7 W
BOOK PAGE 111 LINE 12

DRILLERS' LOG

NAME:	ROXIE ANDERSON #1	DATE SPUDDED:	3-26-55
LOCATION:	SE/4 SW/4 SE/4 Sec.9-27S-7W Kingman County, Kansas	ROTARY COMPLETED:	4-11-55
OPERATOR:	Heathman-Seeligson Drilling Co.	ELEVATION:	1528 GR 1531 DF 1534 KB
CONTRACTOR:	Heathman-Seeligson Drilling Co.	ROTARY TOTAL DEPTH:	4265'
CASING RECORD:	6 jts. 8-5/8" new casing set at 185.95' cemented w/125 sacks cement and 2 Calcium Chloride. Cement Circulated		
OIL STRING:	None run - Dry and abandoned 4-11-55		

GEOLOGICAL TOPS (KB)

Brown Lime	3112 (-1578)
Lansing K.C.	3126 (-1592)
Shale Conglomerate	3738 (-2204)
Mississippian	3821 (-2287)
Kinderhook	3976 (-2442)
Viola	4121 (-2587)
Simpson	4143 (-2609)
Arbuckle	4257 (-2723)
R.T.D.	4265

LOG

(Figures indicate bottom of formation)

Sand & Clay	0 to 40
Shale & Shells	180
Red Bed & Sand	480
Blue Shale	650
Salt & Shells	1020
Lime & Shale	2964
Shale & Lime Sand	3130
Shale & Lime	3350
Lime	3648
Shale & Lime	3834
Lime	3835
Coring	3840
Diamond Core #2	3855
Lime, Shale & Chert	3885
Lime	3975
Shale	4015
Shale & Lime	4115
Lime, Shale & Sand	4127
Core #3	4144
Sand & Lime	4203
Lime & Shale	4265
R.T.D.	4265'

4-14-55


RECEIVED
STATE CORPORATION COMMISSION
APR 14 1955
CONSERVATION DIVISION
Wichita, Kansas

The undersigned, H. D. Shreve, hereby certifies that the above log is a true and correct log of the formations encountered in drilling the above noted well as reflected by the Daily Drilling Reports.

HEATHMAN-SEELIGSON DRILLING CO.

By: 

Subscribed and sworn to before me
this 12th day of April, 1955.

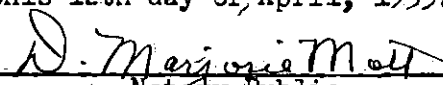
Notary Public

My Commission expires: June 28, 1956

