


STATE OF KANSAS
STATE CORPORATION COMMISSION

WELL PLUGGING RECORD

Give All Information Completely
Make Required Affidavit
Mail or Deliver Report to:
Conservation Division
State Corporation Commission
211 No. Broadway
Wichita, Kansas

NORTH

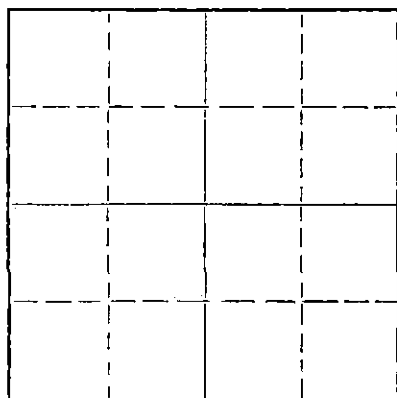

Locate well correctly on above
Section Plat

Kingman County. Sec. 1 Twp. 27S Rge. 7W (X) (W)
Location as "NE/CNW/SW" or footage from lines NE NE SE
Lease Owner Osage Oil & Gas Co., Inc.
Lease Name HYDE Well No. 1
Office Address 531 Petroleum Bldg., Wichita, Kansas
Character of Well (completed as Oil, Gas or Dry Hole) Dry Hole
Date well completed 3-5-57 19__
Application for plugging filed 3-5-57 19__
Application for plugging approved 3-5-57 19__
Plugging commenced 3-5-57 19__
Plugging completed 3-5-57 19__
Reason for abandonment of well or producing formation Dry Hole

If a producing well is abandoned, date of last production _____ 19__
Was permission obtained from the Conservation Division or its agents before plugging was commenced? Yes

Name of Conservation Agent who supervised plugging of this well M. A. Rives, Box 8, Pratt, Kansas
Producing formation _____ Depth to top _____ Bottom _____ Total Depth of Well 4325* Feet
Show depth and thickness of all water, oil and gas formations.

OIL, GAS OR WATER RECORDS

CASING RECORD

FORMATION	CONTENT	FROM	TO	SIZE	PUT IN	PULLED OUT
<u>SAND, SHALE</u>		<u>0</u>	<u>233*</u>	<u>8-5/8"</u>	<u>233*</u>	<u>0</u>

Describe in detail the manner in which the well was plugged, indicating where the mud fluid was placed and the method or methods used in introducing it into the hole. If cement or other plugs were used, state the character of same and depth placed, from _____ feet to _____ feet for each plug set.

Finish laying down Drill Pipe - plugging hole & tearing down. Hole
plugged @5 A.M. Bottom plug @250* W/200 sks. cement 1/2 sack hulls.
Top plug @30* W/10 sks. cement 1/2 sack hulls.

(If additional description is necessary, use BACK of this sheet)

Name of Plugging Contractor Graham-Michaelis Drilling Co.
Address 211 North Broadway, Wichita, Kansas

STATE OF KANSAS, COUNTY OF SEDGWICK, ss.
O. W. Woodland (employee of owner) ~~OF (OWNER OR OPERATOR)~~ of the above-described

well, being first duly sworn on oath, says: That I have knowledge of the facts, statements, and matters herein contained and the log of the above-described well as filed and that the same are true and correct. So help me God. Graham-Michaelis Drilling Co.

(Signature) O. W. Woodland
211 North Broadway, Wichita, Kansas
(Address)

SUBSCRIBED AND SWORN TO before me this 8th day of March, 19 57.

[Signature]

My commission expires 1/7/61.

Notary Public.
STATE CORPORATION COMMISSION
RECORDED 3-9-57
CONSERVATION DIVISION
Wichita, Kansas

PLUGGING
FILE SEC L T 27 R 7w
BOOK PAGE 145 LINE 39

HYDE #1

Well Record

Location: NE NE SE Section 1-27S-7W Kingman County, Kansas
 Commenced: February 14, 1957
 Completed: March 5, 1957 (rotary)

Operator: Osage Oil & Gas Co., Inc., 531 Petroleum Bldg., Wichita, Kansas

Contractor: Graham-Michaelis Drilling Co., 211 North Broadway, Wichita, Kansas

Casing Record: 8 5/8" @233* W/150 sack cement

LOG

Shale & Sand	90
Sand & Shale	335
Shale	900
Shale & Lime	1335
Bro. Lime & Shale	1525
Lime & Shale	1865
Shale-Lime Streaks	2112
Shale-Lime	2640
Lime & Shale	3196
Lime	3235
Lime & Shale	3310
Lime	3358
Lime & Shale	3420
Lime	3469
Lime & Shale	3527
Lime	3541
Shale & Lime	3572
Lime	3645
Lime & Shale	3735
Shale & Lime	3800
Lime-Shale-Chirt	3825
Chert	3850
Chirt & Lime	3908
Cherty Lime	3960
Lime-Chirt	3992
Lime	4028
Lime & Shale	4173
Shale-Lime	4187
Lime (Vida)	4189
Shale-Sand	4212
Sand-Shale	4242
Lime-Shale-Sand	4306
Sand & Arb.	4325, RTD

3-9-57
 RECEIVED
 STATE GEOLOGICAL COMMISSION
 MAR 9 - 1957
 DIVISION

STATE OF KANSAS)
) ss.
 COUNTY OF SEDGWICK)

The undersigned, GRAHAM-MICHAELIS DRILLING COMPANY, hereby certifies that the above log is a true and correct log of the formation encountered in drilling the above well as reflected by the Daily Drilling Report.

PLUGGING			
FILE	SEC	T	R
		27	7W
BOOK	PAGE	LINE	
	145	39	

GRAHAM-MICHAELIS DRILLING CO.

By John L. James
 John L. James, Geologist

Subscribed and sworn to before me this 8th day of March, 1957

My commission expires: 1/7/61