


STATE OF KANSAS
STATE CORPORATION COMMISSION

WELL PLUGGING RECORD

Give All Information Completely
Take Required Affidavit
Mail or Deliver Report to
Conservation Division
State Corporation Comm.
245 North Water
Wichita, KS 67202

Stafford County. Sec. 10 Twp. 24 Rge. 13 E/W
Location as "NE/CNW $\frac{1}{4}$ SW $\frac{1}{4}$ " or footage from lines
SW/4 SW/4 NE/4
Lease Owner Martin Oil Producers, Inc.
Lease Name Spare Well No. 1-10
Office Address 1010 Union Center, Wichita, KS 67202
Character of Well (Completed as Oil, Gas or Dry Hole)
dry hole
Date Well completed 3/18/1982
Application for plugging filed 3/18/1982
Application for plugging approved 3/18/1982
Plugging commenced 3/18/1982
Plugging completed 3/18/1982
Reason for abandonment of well or producing formation
No commercial quantity of oil or gas encountered.
If a producing well is abandoned, date of last production 19

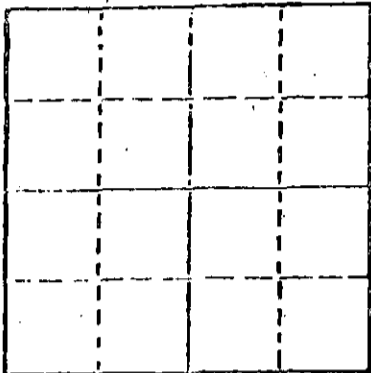

Locate well correctly on above
Section Plat

Was permission obtained from the Conservation Division or
its agents before plugging was commenced? yes

Name of Conservation Agent who supervised plugging of this well Mr. Metz
Producing formation _____ Depth to top _____ Bottom _____ Total Depth of Well _____
Show depth and thickness of all water, oil and gas formations.

OIL, GAS OR WATER RECORDS

CASING RECORD

FORMATION	CONTENT	FROM	TO	SIZE	PUT IN	PULLED OUT

Describe in detail the manner in which the well was plugged, indicating where the mud fluid
was placed and the method or methods used in introducing it into the hold. If cement or other
plugs were used, state the character of same and depth placed, from _____ feet to
_____ feet for each plug set.

Total Depth 4085 feet. Set first plug at 800 feet with 60 sacks
cement; second plug at 240 feet with 40 sacks; 10 sacks and a
bridge at 40 feet and 10 sacks in the rathole. Plug down at
11:30 a.m. on March 18, 1982.

(If additional description is necessary, use BACK of this sheet)

Name of Plugging Contractor Kaw Drilling Co., Inc.

STATE OF KANSAS COUNTY OF SEDGWICK, ss. contractor
K. S. Martin, President of Kaw Drilling Co., Inc. (operator of well)

of the above-described well, being first duly sworn on oath, says: That I have knowledge of
the facts, statements, and matters herein contained and the log of the above-described well
as filed and that the same are true and correct. So help me God.


RECEIVED
STATE CORPORATION COMMISSION

(Signature) K. S. Martin
K. S. Martin, President 1010 Union Center
(Address) Wichita, KS 67202

MAR 23 1982
CONSERVATION DIVISION
SUBSCRIBED AND SWORN TO before me this 22nd day of March, 1982.
Wichita Kansas

Mary Susan Whaley
Mary Susan Whaley Notary Public

My commission expires December 10, 1983

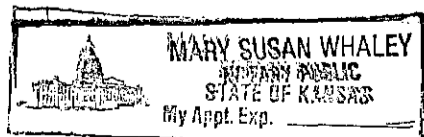

OPERATOR:	Martin Oil Producers, Inc.
CONTRACTOR:	Kaw Drilling Co., Inc.
WELL NAME:	Spare #1-10
LOCATION:	SW SW NE Section 10-24S-13W, Stafford County, Kansas
SPUD DATE:	March 8, 1982
COMPLETION DATE:	March 18, 1982


0	2519	Shale
2519	3854	Lime and Shale
3854	3866	Lime
3866	3926	Shale and Lime
3926	4085	Lime
	4085	R.T.D.

Spud hole at 3:45 p.m. on March 8, 1982. Drilled 776 feet of 12½ inch hole. Ran 18 joints of 8 5/8 inch 23 pound surface casing (tallied at 760.94 feet). Set at 772 feet with 400 sacks common cement, 2% Gel and 3% Calcium Chloride. Cement by Allied Cementing. Plug down at 7:30 a.m. on March 9, 1982.

Total Depth 4085 feet. Set first plug at 800 feet with 60 sacks cement; second plug at 240 feet with 40 sacks; 10 sacks and a bridge at 40 feet and 10 sacks in the rathole. Plug down at 11:00 a.m. on March 18, 1982. State Plugger - Mr. Metz.

STATE OF KANSAS)
) ss
COUNTY OF SEDGWICK)


I, K. S. Martin, President of Kaw Drilling Co., Inc., being first duly sworn and upon my oath, state that: I have knowledge of the facts, statements and matters herein contained and the log of the above described well as filed and that the same are true and correct. So help me God.


K. S. Martin, President

SUBSCRIBED AND SWORN to before me on this 22nd day of March, 1982.


Mary Susan Whaley, Notary Public

My Commission Expires:
December 10, 1983

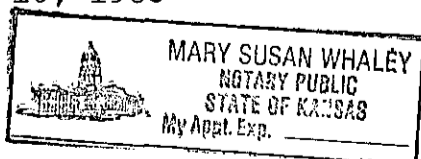

RECEIVED
STATE CONSERVATION COMMISSION

MAR 23 1982
CONSERVATION DIVISION
Wichita Kansas