

15-185-00890-0000

STATE OF KANSAS
STATE CORPORATION COMMISSION

WELL PLUGGING RECORD

Give All Information Completely
Make Required Affidavit
Mail or Deliver Report to:
Conservation Division
State Corporation Commission
800 Biting Building
Wichita, Kansas

Stafford County. Sec. 14 Twp. 24 Rge. 13 (E) (W)

Location as "NE/CNW/SW" or footage from lines NE SW SE

Lease Owner Petroleum, Inc.

Lease Name CORNWELL Well No. 1

Office Address 311 East Third, Wichita, Kansas

Character of Well (completed as Oil, Gas or Dry Hole) Dry Hole

Date well completed August 17, 1954

Application for plugging filed August 17, 1954

Application for plugging approved August 17, 1954


Plugging commenced August 17, 1954

Plugging completed August 17, 1954

Reason for abandonment of well or producing formation Dry Hole

If a producing well is abandoned, date of last production 19

Was permission obtained from the Conservation Division or its agents before plugging was commenced? Yes

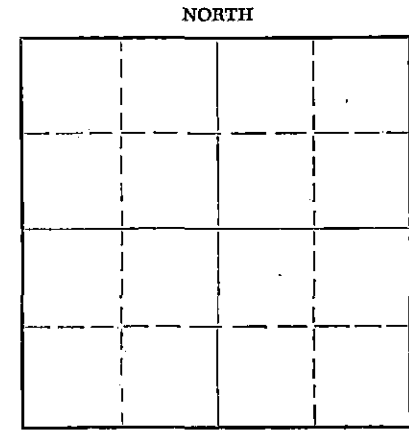

Locate well correctly on above Section Plat

Name of Conservation Agent who supervised plugging of this well Mr. M. A. Rives

Producing formation _____ Depth to top _____ Bottom _____ Total Depth of Well 4126 Feet

Show depth and thickness of all water, oil and gas formations.

OIL, GAS OR WATER RECORDS

CASING RECORD

FORMATION	CONTENT	FROM	TO	SIZE	PUT IN	PULLED OUT
				8-5/8"	210'	None

Describe in detail the manner in which the well was plugged, indicating where the mud fluid was placed and the method or methods used in introducing it into the hole. If cement or other plugs were used, state the character of same and depth placed, from _____ feet to _____ feet for each plug set.

Mudded up to 210' and set first wooden plug at 210'. Placed 1/4 sack hulls on top of plug. Displaced 20 sacks through drill pipe on top of hulls. Mudded up to 35' and set second wooden plug and placed 1/4 sack hulls on top of plug. Filled hole to base of well cellar with 10 sacks cement. 8-27-54

(If additional description is necessary, use BACK of this sheet)

Name of Plugging Contractor Garvey Drilling Company
Address R. R. #2, Great Bend, Kansas

STATE OF KANSAS, COUNTY OF SEDGWICK, ss. Karl E. Becker (employee of owner) of the above-described well, being first duly sworn on oath, says: That I have knowledge of the facts, statements, and matters herein contained and the log of the above-described well as filed and that the same are true and correct. So help me God.

(Signature) Karl E. Becker
311 East Third, Wichita, Kansas
(Address)

SUBSCRIBED AND SWORN to before me this 20th day of August, 19 54

My commission expires July 8, 1958 D. M. Kennedy Notary Public.

24-7368-S 3-53-20M

PLUGGING
FRA SEC 14 T 24 R 13W
BOOK PAGE 57 LINE 24

15-185-00890-0000

WELL LOG

COMPANY **Petroleum, Inc.**

SEC. **14** T. **24** R. **13**

FARM **CORNWELL**

NO. **1**

LOC. **NE SW SE**


TOTAL DEPTH **4126**

COUNTY **Stafford County**

COMM. **August 7, 1954**

COMP. **August 17, 1954**

CONTRACTOR **Garvey Drilling Company**

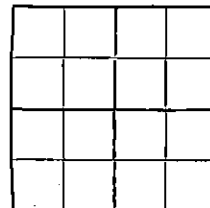

CASING **8-5/8" @ 210' w/175 cas.**

ELEVATION **1909' RB**

PRODUCTION **D & A**

FIGURES INDICATE BOTTOM OF FORMATIONS

140	Sand
210	Red Bed & Blue Shale
240	Blue Shale
745	Red Bed
775	Anhydrite
1100	Shale & Shells
3550	Lime & Shale
3861	Lime
3908	Lime & Shale
4013	Chert
4101	Shale
4126	Lime
4126	T.D.

Tops:

Heobner:	3369 (-2160)
Brown Lime:	3510 (-2601)
Lansing:	3538 (-1629)
Viola:	3907 (-1998)
Simpson:	4012 (-2133)
Arbuckle:	4101 (-2192)

8-27-54

PLUGGING
 PER SEC. 14 T. 24 R. 13W
 COOK PAGE 57 LINE 24

RECEIVED
 STATE CORPORATION COMMISSION
 AUG 27 1954
 CONSERVATION DIVISION
 Wichita, Kansas

State of KANSAS
 County of SEDERWICK } ss:

I, Karl E. Becker of Petroleum, Inc.

upon oath state that the above and foregoing is a true and correct copy of the log of the CORNWELL #1 well.

Subscribed and sworn to before me this 25th day of August 1954

My Commission Expires: July 8, 1958

Karl E. Becker
D. M. Kennedy
 NOTARY PUBLIC