

WELL PLUGGING RECORD


STATE OF KANSAS STATE CORPORATION COMMISSION

Give All Information Completely Make Required Affidavit Mail or Deliver Report to: Conservation Division State Corporation Commission 800 Bitting Building Wichita, Kansas

FORMATION PLUGGING RECORD

Strike out upper line when reporting plugging off formations.

Stafford County, Sec. 14 Twp. 24 Rge. (E) 13 (W) Location as "NE 1/4 NW 1/4 SW 1/4" or footage from lines NW/4 NE/4 SW/4 Lease Owner Musgrove Petroleum Corporation Lease Name Roohms Well No. 1 Office Address 407 K.F.H. Building, Wichita 2, Kansas Character of Well (completed as Oil, Gas or Dry Hole) Dry Hole Date well completed 12-31 1948 Application for plugging filed (Via Telephone) 12-31 1948 Application for plugging approved 12-31 1948 Plugging commenced 12-31 1948 Plugging completed 12-31 1948 Reason for abandonment of well or producing formation Dry

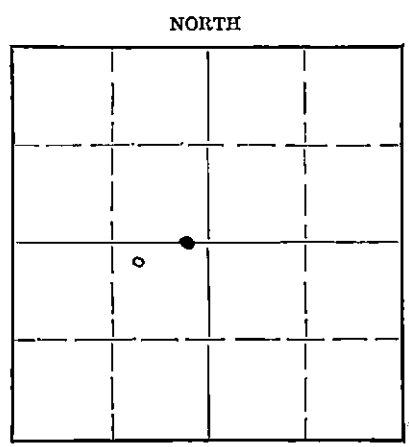

Locate well correctly on above Section Plat

If a producing well is abandoned, date of last production 19. Was permission obtained from the Conservation Division or its agents before plugging was commenced? Agent

Name of Conservation Agent who supervised plugging of this well C. D. Stough Producing formation Depth to top Bottom Total Depth of Well 4123 Feet Show depth and thickness of all water, oil and gas formations.

OIL, GAS OR WATER RECORDS

CASING RECORD

Table with 7 columns: Formation, Content, From, To, Size, Put In, Pulled Out. The table is currently empty.

Describe in detail the manner in which the well was plugged, indicating where the mud fluid was placed and the method or methods used in introducing it into the hole. If cement or other plugs were used, state the character of same and depth placed, from feet to feet for each plug set.

Filled hole with heavy mud to 298'. Set a wooden plug. Filled with 15 sacks of cement. Filled with heavy mud to within 25' of top of hole. Ran another wooden plug. Filled with 10 sacks of cement to top of hole.

RECEIVED Conservation Division JAN 5 1949 STAFFORD COUNTY COMMISSION 1-5-49

(If additional description is necessary, use BACK of this sheet). Correspondence regarding this well should be addressed to Musgrove Petroleum Corporation 407 K.F.H. Building Wichita 2, Kansas


STATE OF KANSAS, COUNTY OF SEDGWICK, ss. P. C. Musgrove (owner or operator) of the above-described well, being first duly sworn on oath, says: That I have knowledge of the facts, statements, and matters herein contained and the log of the above-described well as filed and that the same are true and correct. So help me God.

(Signature) P. C. Musgrove 407 K.F.H. Bldg., Wichita 2, Kansas (Address)

SUBSCRIBED AND SWORN to before me this 4th day of January, 1949.

Madeline J. Irrell Notary Public.

My commission expires December 5, 1951

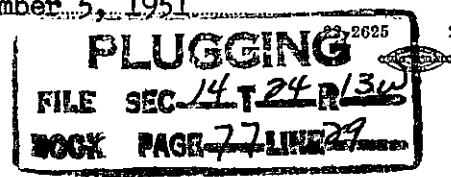

CONTRACTOR'S WELL LOG

Operator Musgrove Petroleum Corporation Farm Name Roohms #1

Location NW $\frac{1}{4}$ NE $\frac{1}{4}$ SW $\frac{1}{4}$ Sec. 14-24-13W.

Pool Name WC County Stafford State Kansas

Commencement Date 12-15-48 Completion Date 12-31-48

LOG OF WELL

Elevation 1910'

All measurements from the top of rotary bushing.

DEPTH		FORMATION	DEVIATION		REMARKS:
FROM	TO		FROM	VERTICAL	
0	145	Sand			
145	295	Red Bed-Shale			
295	750	Red-Bed-Shale			
750	777	Anhydrite			
777	1245	Shale-Shells-Red Bed	1000'	- 0°	
1245	1675	Shale-Shells	1500'	- 0°	
1675	1850	Shale-Lime	1750'	- 0°	
1850	2020	Lime-Shale	2000'	- 0°	
2020	2145	Lime			
2145	2315	Lime-Shale			
2315	2460	Shale-Lime			
2460	2580	Shale-Lime	2500'	- 0°	
2580	2805	Shale-Shells			
2805	2940	Shale-Lime			
2940	3070	Shale-Lime	3000'	- 0°	
3070	3185	Lime-Shale			
3185	3300	Shale-Lime			
3300	3360	Lime-Shale			
3360	3405	Lime-Shale			
3405	3475	Shale-Lime			
3475	3570	Shale-Lime			
3570	3630	Lime			
3630	4123	Lime			

CASING LEFT IN HOLE AFTER COMPLETION

298.88' (14 jts.) 8-5/8" OD Surface Casing.

STATE OF KANSAS, COUNTY OF SEDGWICK, ss.

The undersigned certifies that to the best of his knowledge and belief, the above facts are true and correct.

C-G DRILLING COMPANY, Inc.

By R A Cook, President

Subscribed and sworn to before me this 4th day of January, 1948.

My commission expires:
June 25, 1951

Vicki Lutz
Notary Public

PLUGGING
FILE SEC. 14-24-13W
DECK FAC. 77-1-29

1-5-49
RECEIVED
JAN X 5 1948
STATE OF KANSAS