


Give All Information Completely
Make Required Affidavit
Mail or Deliver Report to:
Conservation Division
State Corporation Commission
211 No. Broadway
Wichita, Kansas

WELL PLUGGING RECORD

Stafford County. Sec. 22 Twp. 24 Rge. (E) 13 (W)
Location as "NE/CNW/SW" or footage from lines SE NE NW
Lease Owner Morris Garvin
Lease Name Redd Well No. 1
Office Address St. John, Kansas
Character of Well (completed as Oil, Gas or Dry Hole) dry hole
Date well completed November 8 19 65
Application for plugging filed Nov November 8 19 65
Application for plugging approved 19
Plugging commenced 8:00 a.m., November 8, 1965 19
Plugging completed 10:00 a.m., November 8, 1965 19
Reason for abandonment of well or producing formation dry hole

If a producing well is abandoned, date of last production 19
Was permission obtained from the Conservation Division or its agents before plugging was commenced? Yes

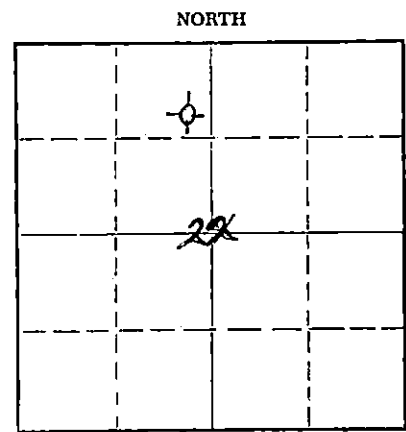

Locate well correctly on above Section Plat

Name of Conservation Agent who supervised plugging of this well ~~XXXXXXXX~~ Archie Elwing
Producing formation _____ Depth to top _____ Bottom _____ Total Depth of Well _____ Feet
Show depth and thickness of all water, oil and gas formations.

OIL, GAS OR WATER RECORDS

CASING RECORD

FORMATION	CONTENT	FROM	TO	SIZE	PUT IN	PULLED OUT
		0'	380'	8 5/8"	380'	none

Describe in detail the manner in which the well was plugged, indicating where the mud fluid was placed and the method or methods used in introducing it into the hole. If cement or other plugs were used, state the character of same and depth placed, from _____ feet to _____ feet for each plug set.
Bottom plug at 275' with 1/4 sack hulls and 25 sx cement.
Top plug at 40' with 1/2 sack hulls and 10 sx cement.
2 sacks cement in rat hole.

11-9-65
NOV 9 1965
RECEIVED
CONSERVATION DIV.
WICHITA, KANSAS

(If additional description is necessary, use BACK of this sheet)

Name of Plugging Contractor Vaughan Drilling, Inc.
Address Box 825, Great Bend, Kansas

STATE OF KANSAS, COUNTY OF BARTON, ss.
Wayne Dobbs (employee of owner) or (owner or operator) of the above-described well, being first duly sworn on oath, says: That I have knowledge of the facts, statements, and matters herein, contained and the log of the above-described well as filed and that the same are true and correct. So help me God.

(Signature) Wayne Dobbs
Vaughan Drilling, Inc., by: Wayne Dobbs, V-Pres.
Box 825, Great Bend, Kansas
(Address)

SUBSCRIBED AND SWORN TO before me this 8th day of November, 19 65

My commission expires August 27, 1969

Delores Strecker
Delores Strecker
Notary Public.

WELL LOG

COMPANY	Morris Garvin
CONTRACTOR	Vaughan Drilling, Inc.
FARM	#1 Redd
LOCATION	SE NE NW OF SEC. 22-24-13W Stafford County, Kansas
ELEVATION	1919' K. B.
SURFACE PIPE	8 5/8" surface pipe at 380' with 300 sx cement.
PRODUCTION	D & A.
COMMENCED	11-1-65
COMPLETED	11-8-65

<u>FORMATION</u>	<u>DEPTH</u>
Sandstone & Clay Streak	140
Shale	155
Red Bed	245
Sandstone	278
Red Bed (Sandy)	770
Anhydrite	792
Shale & Shells	1415
Limestone & Shale	1867
Limestone	1960
Limestone & Shale	2295
Limestone (Sandy)	2330
Limestone & Shale	3380
Limestone	3569
Rotary Total Depth	3569

Formation Tops

Heebner	3403 (-1484)
Brown Lime	3539 (-1620)
Lansing	3567 (-1648)

A F F I D A V I T

STATE OF KANSAS, COUNTY OF BARTON, SS:

I, Wayne Dobbs, of the VAUGHAN DRILLING, INC., being first duly sworn on oath, state; that I have knowledge of the facts, statements and matters herein contained and that the same are true and correct.

Wayne Dobbs
 Wayne Dobbs, Vice-Pres.

Subscribed and sworn to before me this 8th day of November, 1965.

Delores Strecker
 Delores Strecker, Notary Public

My Commission Expires Aug. 27, 1969

RECEIVED
STATE DEPARTMENT OF REVENUE

NOV 9 1965

GOVERNMENT DIVISION
Wichita, Kansas