


STATE OF KANSAS
STATE CORPORATION COMMISSION

WELL PLUGGING RECORD

*Give All Information Completely
Make Required Affidavit
Mail or Deliver Report to:
Conservation Division
State Corporation Commission
800 Bittling Building
Wichita, Kansas

NORTH

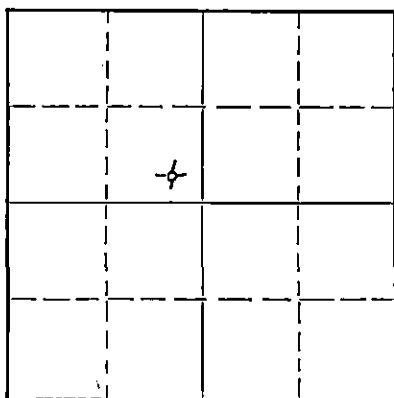

Locate well correctly on above
Section Plat

Stafford County. Sec. 22 Twp. 24S. Rge. 13 (E) W. (W)
Location as "NE/CNW/4SW/4" or footage from lines SE SE NW
Lease Owner Peel*Hardman
Lease Name McNaghten Well No. 1
Office Address P. O. Box 359, Hoisington, Kansas
Character of Well (completed as Oil, Gas or Dry Hole) Dry Hole
Date well completed December 15 1950
Application for plugging filed December 15 1950
Application for plugging approved December 15 1950
Plugging commenced December 15 1950
Plugging completed December 15 1950
Reason for abandonment of well or producing formation Dry Hole

If a producing well is abandoned, date of last production 19
Was permission obtained from the Conservation Division or its agents before plugging was commenced? Yes

Name of Conservation Agent who supervised plugging of this well C. D. Stough
Producing formation Depth to top Bottom Total Depth of Well 4195 Feet
Show depth and thickness of all water, oil and gas formations.

OIL, GAS OR WATER RECORDS

CASING RECORD

Formation	Content	From	To	Size	Put In	Pulled Out
		0	304 1/2'	8 5/8"	304 1/2'	None

Describe in detail the manner in which the well was plugged, indicating where the mud fluid was placed and the method or methods used in introducing it into the hole. If cement or other plugs were used, state the character of same and depth placed, from feet to feet for each plug set.

From 4195' to 281 1/2' - Heavy Rotary Mud
From 281 1/2' to 280' - Wooden plug
From 280' to 234' - 15 sacks cement
From 234' to 31 1/2' - Heavy Rotary Mud
From 31 1/2' to 30' - Wooden Plug
From 30' to 6' - 10 sacks cement
From 6' to Surface - Cellar

12-26-50

RECEIVED
STATE CORPORATION COMMISSION
DEC 26 1950
CONSERVATION DIVISION
Wichita, Kansas

(If additional description is necessary, use BACK of this sheet)

Correspondence regarding this well should be addressed to Peel-Hardman
Address P. O. Box 359, Hoisington, Kansas

STATE OF Kansas, COUNTY OF Barton, ss.
Glenn Peel Drilling Company, Inc. (employee of owner) or (owner or operator) of the above-described well,
being first duly sworn on oath, says: That I have knowledge of the facts, statements, and matters herein contained and the log of the above-described well as filed and that the same are true and correct. So help me God. GLENN PEEL DRILLING CO., INC.

(Signature) BY: [Signature]
P. O. BOX 359, HOISINGTON, KANSAS
(Address)

SUBSCRIBED AND SWORN TO before me this 22nd day of December, 1950

[Signature] Notary Public.

My commission expires June 4, 1951

PLUGGING
FILE SEC 22 T 24 R 13
BOOK PAGE 49 LINE 32

DRILLER'S LOG

Company: Peel-Hardman
 Farm: McNaghten Well No. 1
 Total Depth: 4195'
 Comm: 11-30-50 Comp: 12-15-50
 Contractor: Glenn Peel Drilling Co., Inc.
 Casing: 8 5/8" 30 1/2' Gem.

Sec. 22 Twp. 24S Rge. 13W
 SE SE NW
 County: Stafford,
 Kansas
 Elevation:
 Production: Dry

Figures below indicate bottom of formation:

Surface Soil	0 -	45
Sand		80
Sandy Shale		305
Shale and Red Bed		770
Anhydrite		795
Shale		1295
Salt and Shale		1450
Shale and Shells		1695
Shale and Broken Lime		1912
Sand and Shale		2000
Lime		2320
Shale and Lime		3140
Lime		3230
Lime W/ Shale Streaks		3380
Lime		3885
Lime and Chert		4075
Lime, Chert and Shale		4125
Lime		4195
Total Depth		4195

This is to certify that the above information is, to the best of our knowledge, true and correct.

GLENN PEEL DRILLING COMPANY, INC. 12-26-50

BY: *J. B. [Signature]*
 STATE COMMISSIONER OF LANDS AND MINES
 DEC 20 1950

SBUSCRIBED AND SWORN to before me this 22nd day of December, 1950, at

My commission expires June 4, 1951 *Marion M. Kestel*
 Wichita, Kansas

PLUGGING
 FILE SEC-22T-24R-13a
 BOOK PAGE-49LINE-32