


STATE OF KANSAS
STATE CORPORATION COMMISSION
CONSERVATION DIVISION
P. O. BOX 17027
WICHITA, KANSAS 67217

FORM CP-4

WELL PLUGGING RECORD

Stafford County, Sec. 21 Twp. 24 Rge. (E) 13 (W)
Location as "NE/CNWSW4" or footage from lines S/2 N/2 NE/4
Lease Owner Aspen Drilling Co.
Lease Name Owen Well No. 1
Office Address P. O. Box 783, Great Bend, Kansas
Character of Well (completed as Oil, Gas or Dry Hole) 7
Date well completed 19 74
Application for plugging filed July 19 74
Application for plugging approved July 19 74
Plugging commenced July 5 19 74
Plugging completed July 9 19 74
Reason for abandonment of well or producing formation 7

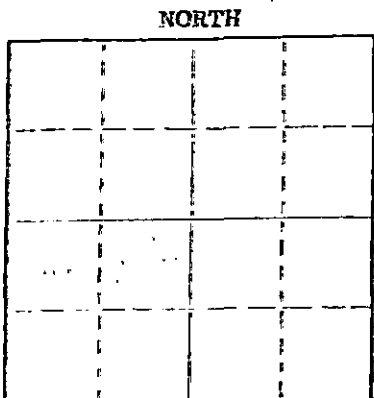

Locate well correctly on above Section Plat

If a producing well is abandoned, date of last production 19
Was permission obtained from the Conservation Division or its agents before plugging was commenced? YES

Name of Conservation Agent who supervised plugging of this well G. Russell Biberstein
Producing formation _____ Depth to top _____ Bottom _____ Total Depth of Well _____ Feet
Show depth and thickness of all water, oil and gas formations.

OIL, GAS OR WATER RECORDS

CASING RECORD

FORMATION	CONTENT	FROM	TO	SIZE	PUT IN	PULLED OUT
	RECEIVED			8 5/8"	310'	none
	STATE CORPORATION COMMISSION			5 1/2"	2001'	1475'
	SEP 30 1974					
	CONSERVATION DIVISION		9-30-74			
	Wichita, Kansas					

Describe in detail the manner in which the well was plugged, indicating where the mud fluid was placed and the method or methods used in introducing it into the hole. If cement or other plugs were used, state the character of same and depth placed, from _____ feet to _____ feet for each plug set.

7-5-74 Plug off bottom. Dumped sand to 1800'. Mixed and dumped 5 sx. cement.
7-31-74 Mixed & pumped 10 sx premium Gel, 3 sx hulls, followed by 100 sx 50/50 Pozmix 2% gel down 8 5/8" casing.

(If additional description is necessary, use BACK of this sheet)

Name of Plugging Contractor Russ Casing Pulling
Address Great Bend, Kansas

STATE OF Kansas COUNTY OF Barton ss.
Robert L. Pelster (employee of owner) or (owner or operator) of the above-described

well, being first duly sworn on oath, says: That I have knowledge of the facts, statements, and matters herein contained and the log of the above-described well as filed and that the same are true and correct. So help me God.

(Signature) [Signature]
Robert L. Pelster, Great Bend, Kansas
(Address)

Subscribed and sworn to before me this 23rd day of September 19 74



My commission expires April 18, 1976
Theora Holleman
Theora Holleman Notary Public.

KANSAS GEOLOGICAL SOCIETY
 KANSAS WELL LOG BUREAU - KANSAS WELL SAMPLE BUREAU
 KANSAS GEOLOGICAL SOCIETY BUILDING
 508 EAST MURDOCK - WICHITA, KANSAS

15-185-20449-0000

COMPANY Aspen Drilling Co.

SEC. 21 T. 24S R. 13W
 LOG. S/2 N/2 NE/4

FARM Owen

NO. 1

COUNTY Stafford
 KANSAS

TOTAL DEPTH 2,004'


COMM. June 12, 1973

COMP. June 16, 1973

SHOT OR TREATED

CONTRACTOR H-30, Inc.

ISSUED

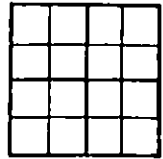

CASING

DEPTH	DIAMETER	DESCRIPTION	ELEVATION	PRODUCTION
20	10			
15	8	-5/8" 310' cemented w/225 sxs cement		
12	6			
13	5	1/2" 2,003' cemented w/150 sxs cement		

FIGURES INDICATE BOTTOM OF FORMATIONS

Sand	130'
Red Bed and Sand	312'
Red Bed, Shale & Shells	840'
Shale	1,635'
Shale and Lime	1,750'
Lime and Shale	1,895'
Shale and Lime	2,004'
Rotary Total Depth	2,004'

7-8-74
 RECEIVED
 STATE CORPORATION CO.
 JUL 8 1974
 CONSERVATION DIVISION
 Wichita, Kansas

I hereby certify the above and foregoing to be a true and correct log of the above described well as shown by the drilling reports.

H-30, INC.

Dean Britting
 Dean Britting

State of Kansas

County of Sedgwick

ss:

Subscribed and Sworn to before me a Notary Public in and for said county and state this 25th. day of June, 1973.

Elsie Willison
 Elsie Willison - Notary Public

